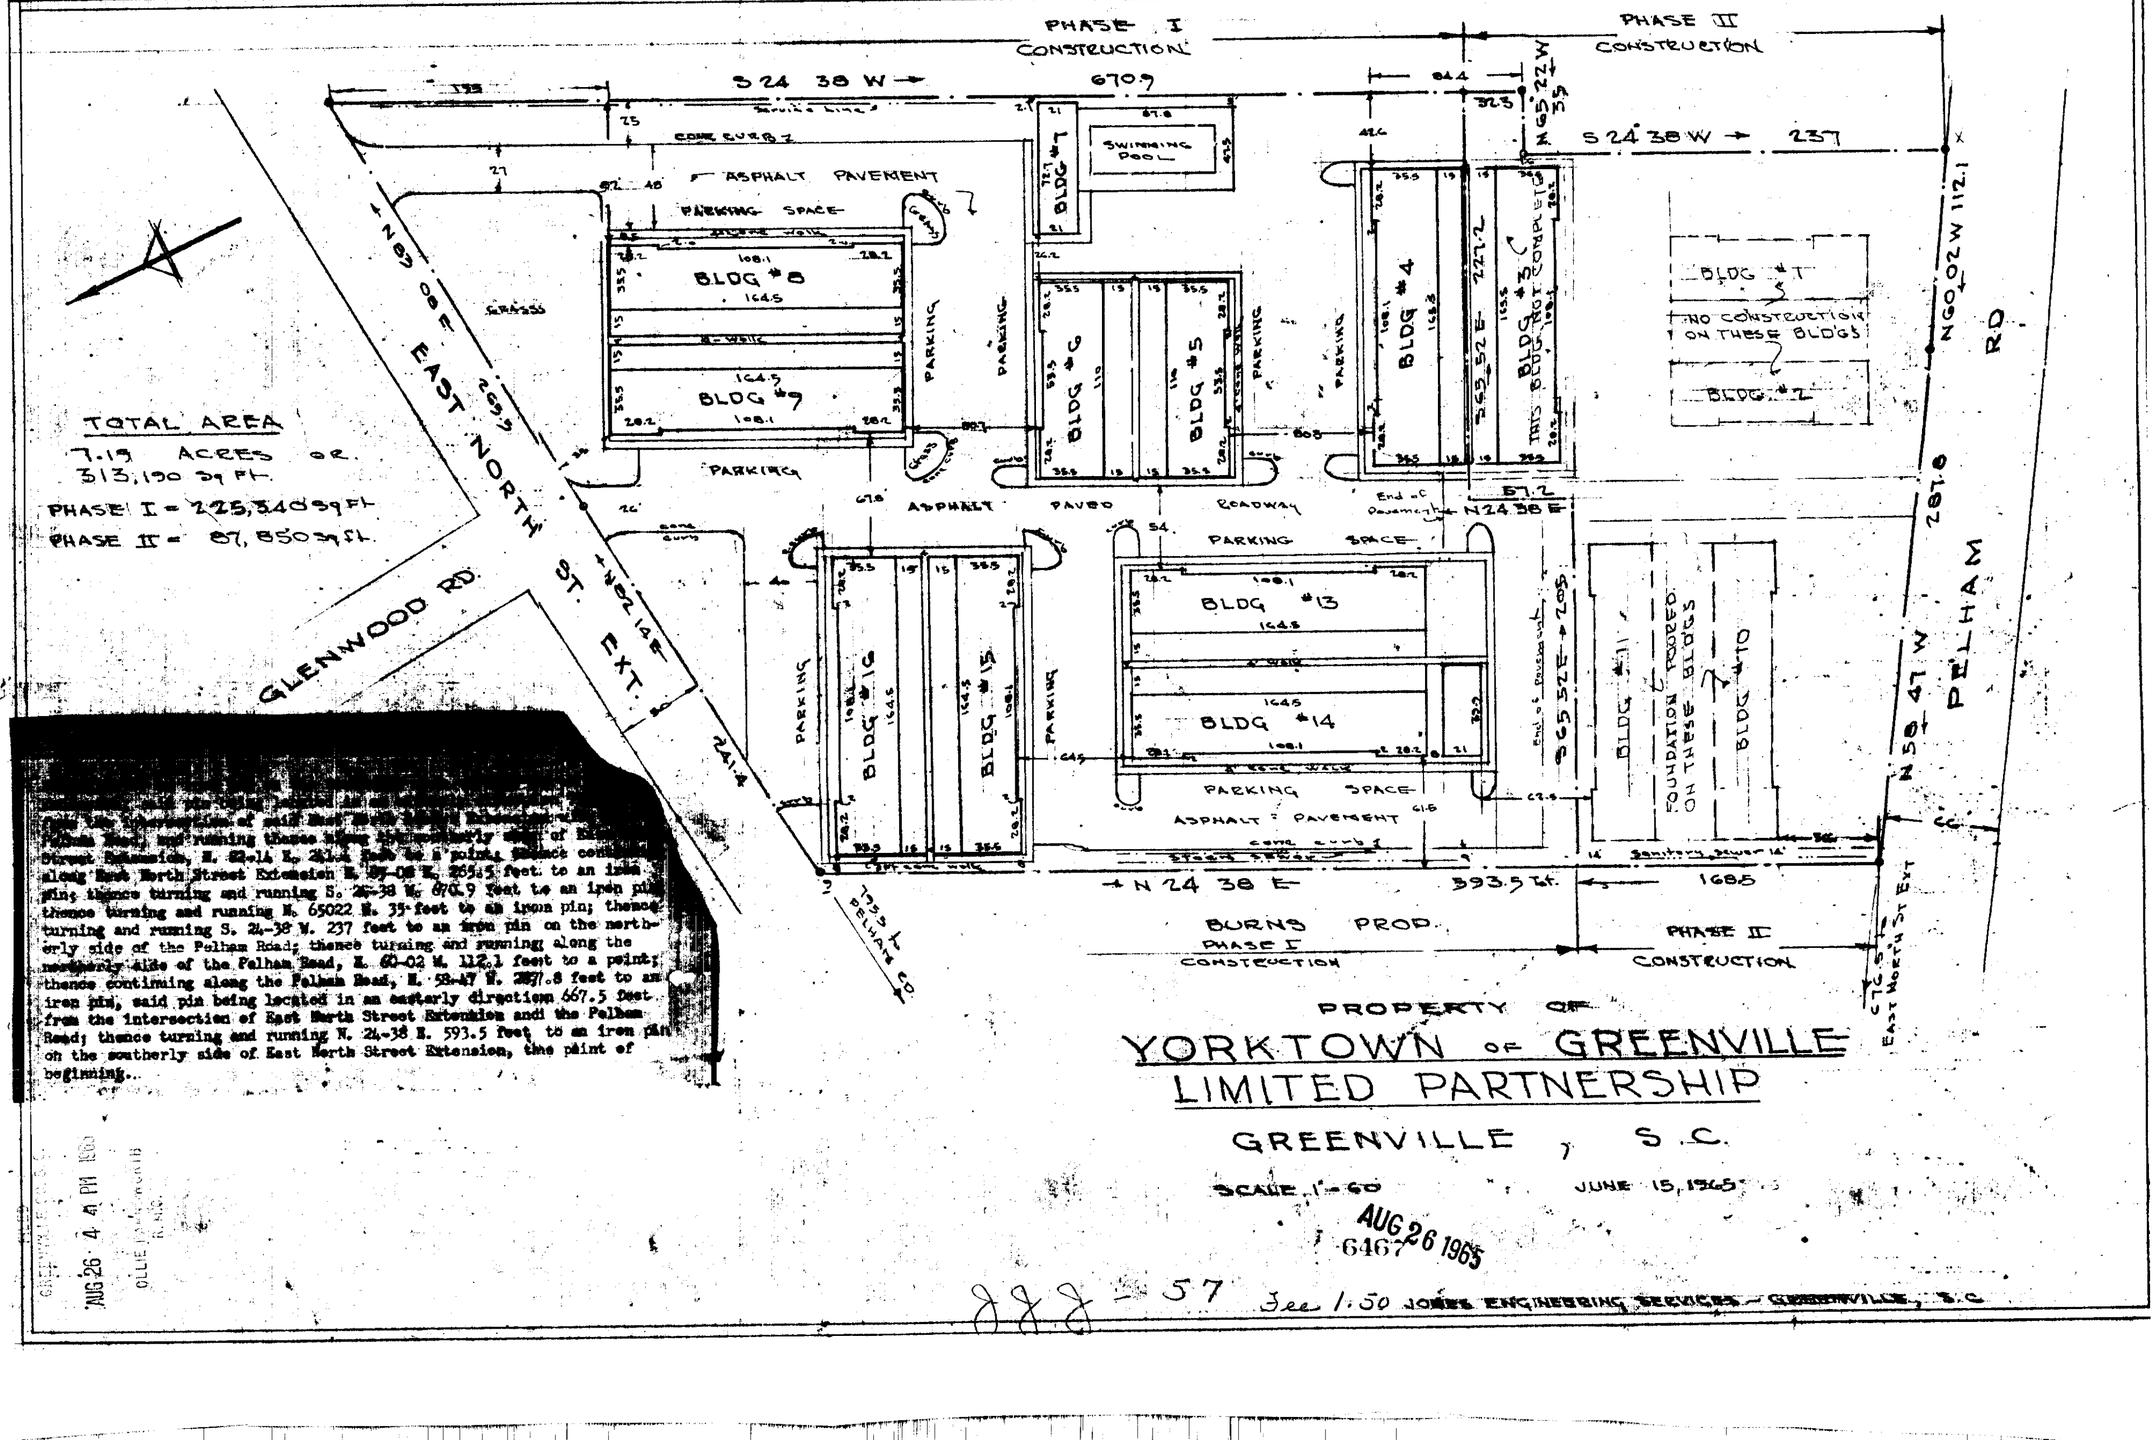
PHASE I CONSTRUCTION
PHASE II CONSTRUCTION
S 24 38 W → 670.9
S 24 38 W → 237
N 65 22 W
N 65 22 W 35
N 60 02 W 112.1
N 24 38 E
N 24 38 E 393.5 ft.
N 58 47 W
ASPHALT PAVEMENT
PARKING SPACE
SWIMMING POOL
BLDG #6
BLDG #7
BLDG #8
BLDG #9
BLDG #5
BLDG #4
BLDG #3
BLDG #T
BLDG #Z
BLDG #13
BLDG #14
BLDG #15
BLDG #16
BLDG #11
BLDG #10
