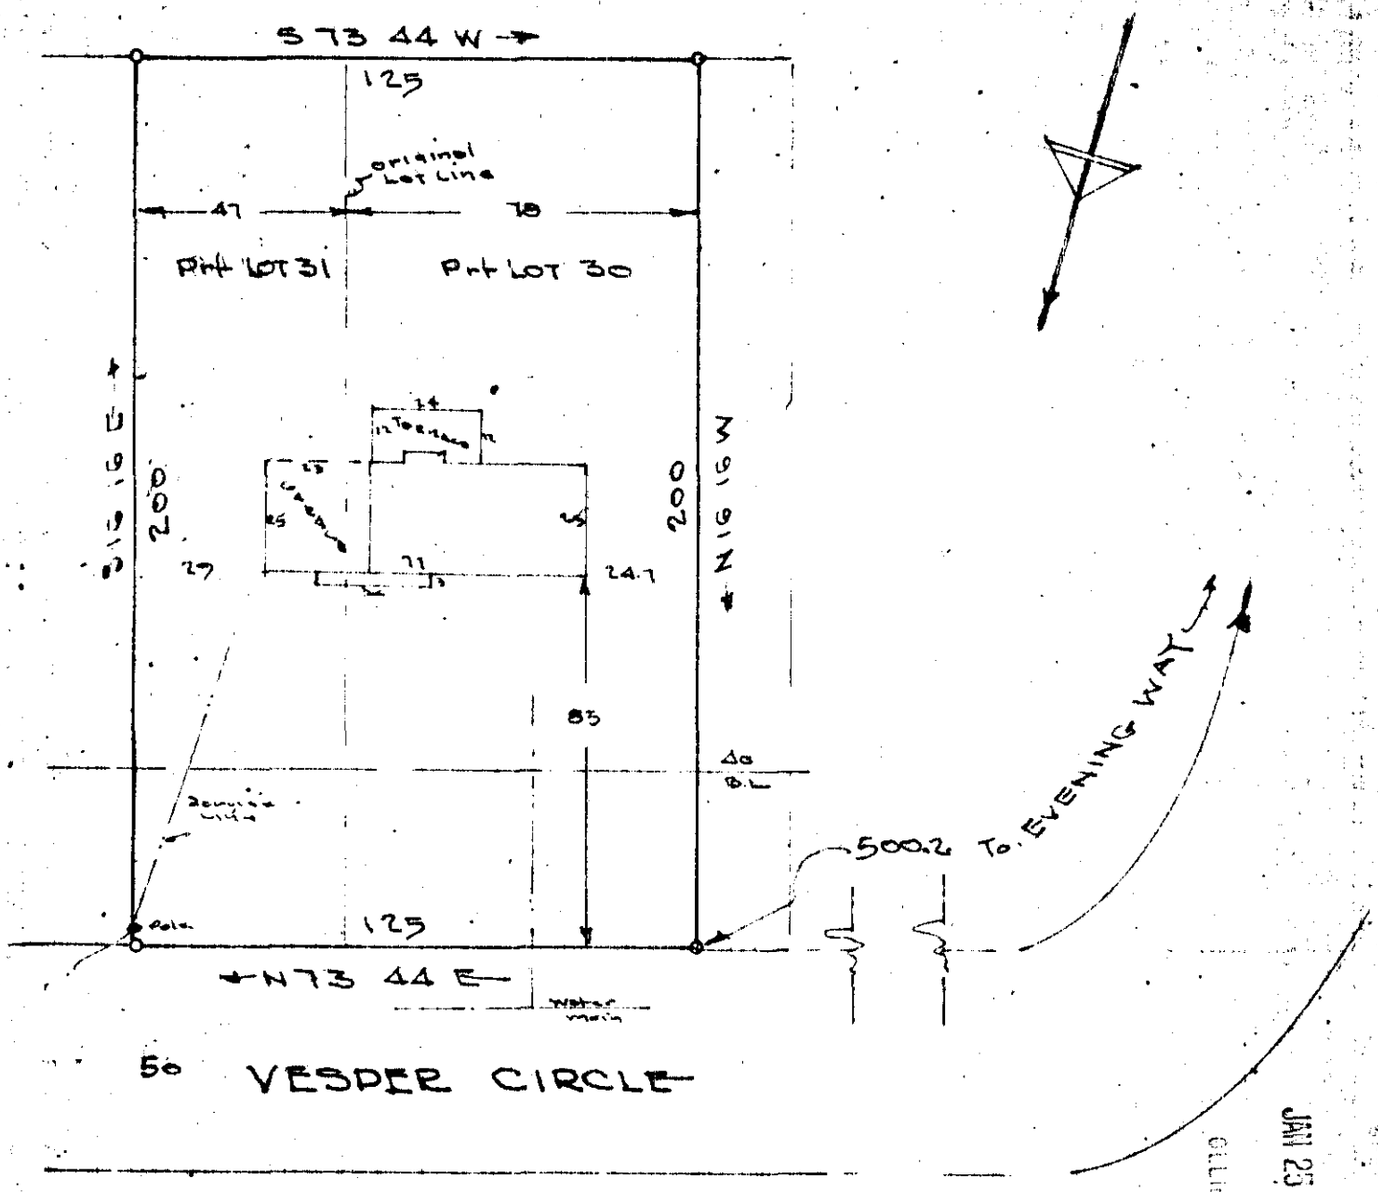

JAN 25 9 06 AM 1966

21792

PROPERTY OF

DANIEL A. REINMAN
AND
ANGELA L. REINMAN

MAULDIN, S.C.

GREENVILLE COUNTY

Scale 1"=40' JAN 22 1966

LLL - 167

This is to certify that on the 22nd day of JAN 1966, I surveyed the property shown on this plat, being Part of LOTS 30 & 31 SUNSET HEIGHTS, recorded in Plat Book RR Pg 85 of the R.M.C. Office for Greenville County, S. C., and that the property lines, walls and buildings are as shown hereon; that the buildings located on said lot do not encroach or project on adjacent streets or property; and that no adjacent buildings or walls encroach or project on said premises, and that no utility lines cross this property.

Reg. Engineer No. 1144 S.C.

See 50 ft

JONES ENGINEERING SERVICES - GREENVILLE S.C.

21792 Filed This 25 day of JAN 1966

And Recorded in Vol. 888 Page 167 at 9:06 A.M

Odia Bonnewitz

Register Mesne Conveyance Greenville County, S. C.