


 

| KEY FOR ONE PERSHING DIVISION | | | |
|-----------------------------------|-------------------|-------------------|-------------------|
| UNIT | REQUIRED | FURNISHED | REQUIRED |
| | AND NOT FURNISHED | AND NOT FURNISHED | AND NOT FURNISHED |
| 1 DIVISION HEADQUARTERS | 1 | | |
| 2 FIELD SIGNAL BATTALION | 1 | | |
| 3-6 INFANTRY BRIGADE HEADQUARTERS | 2 | 2 | |
| 7-9 INFANTRY REGIMENTS | 4 | 9 | |
| DIVISION MACHINE GUN BATTALION | | | 1 |
| BRIGADE MACHINE GUN BATTALION | | | 2 |
| TRENCH MORTAR BATTERY | | | 1 |
| 20 ARTILLERY BRIGADE HEADQUARTERS | 1 | | |
| 21-22 LIGHT ARTILLERY REGIMENTS | 2 | | |
| 23 HEAVY ARTILLERY REGIMENTS | 1 | | |
| 24 ENGINEERS REGIMENT | 1 | | |
| 25 ENGINEERS TRAIN | 1 | | |
| 26 HEADQUARTERS - MILITARY RULE | 1 | | |
| 27 AMUNITION TRAIN | 1 | | |
| 28 SANITARY TRAIN | 1 | | |
| 29 SUPPLY TRAIN | 1 | | |
| 30 MOBILE ORDNANCE REPAIR SHOP | 1 | | |


MARCH 1919.


MAP REVISED TO SHOW FEATURES THAT MAY BE RESERVED FOR GOVERNMENT USE.

 WAREHOUSE, HOSPITAL, AND REMOUNT AREAS THAT ARE TO BE KEPT UNDISTURBED IF RETAINED, AND FOR WHICH NECESSARY UTILITIES OUTSIDE THE AREAS ARE TO BE PRESERVED.

 WATER LINES - SERVING AREAS

 SEWER " " "

 ELECTRIC LINES " " "

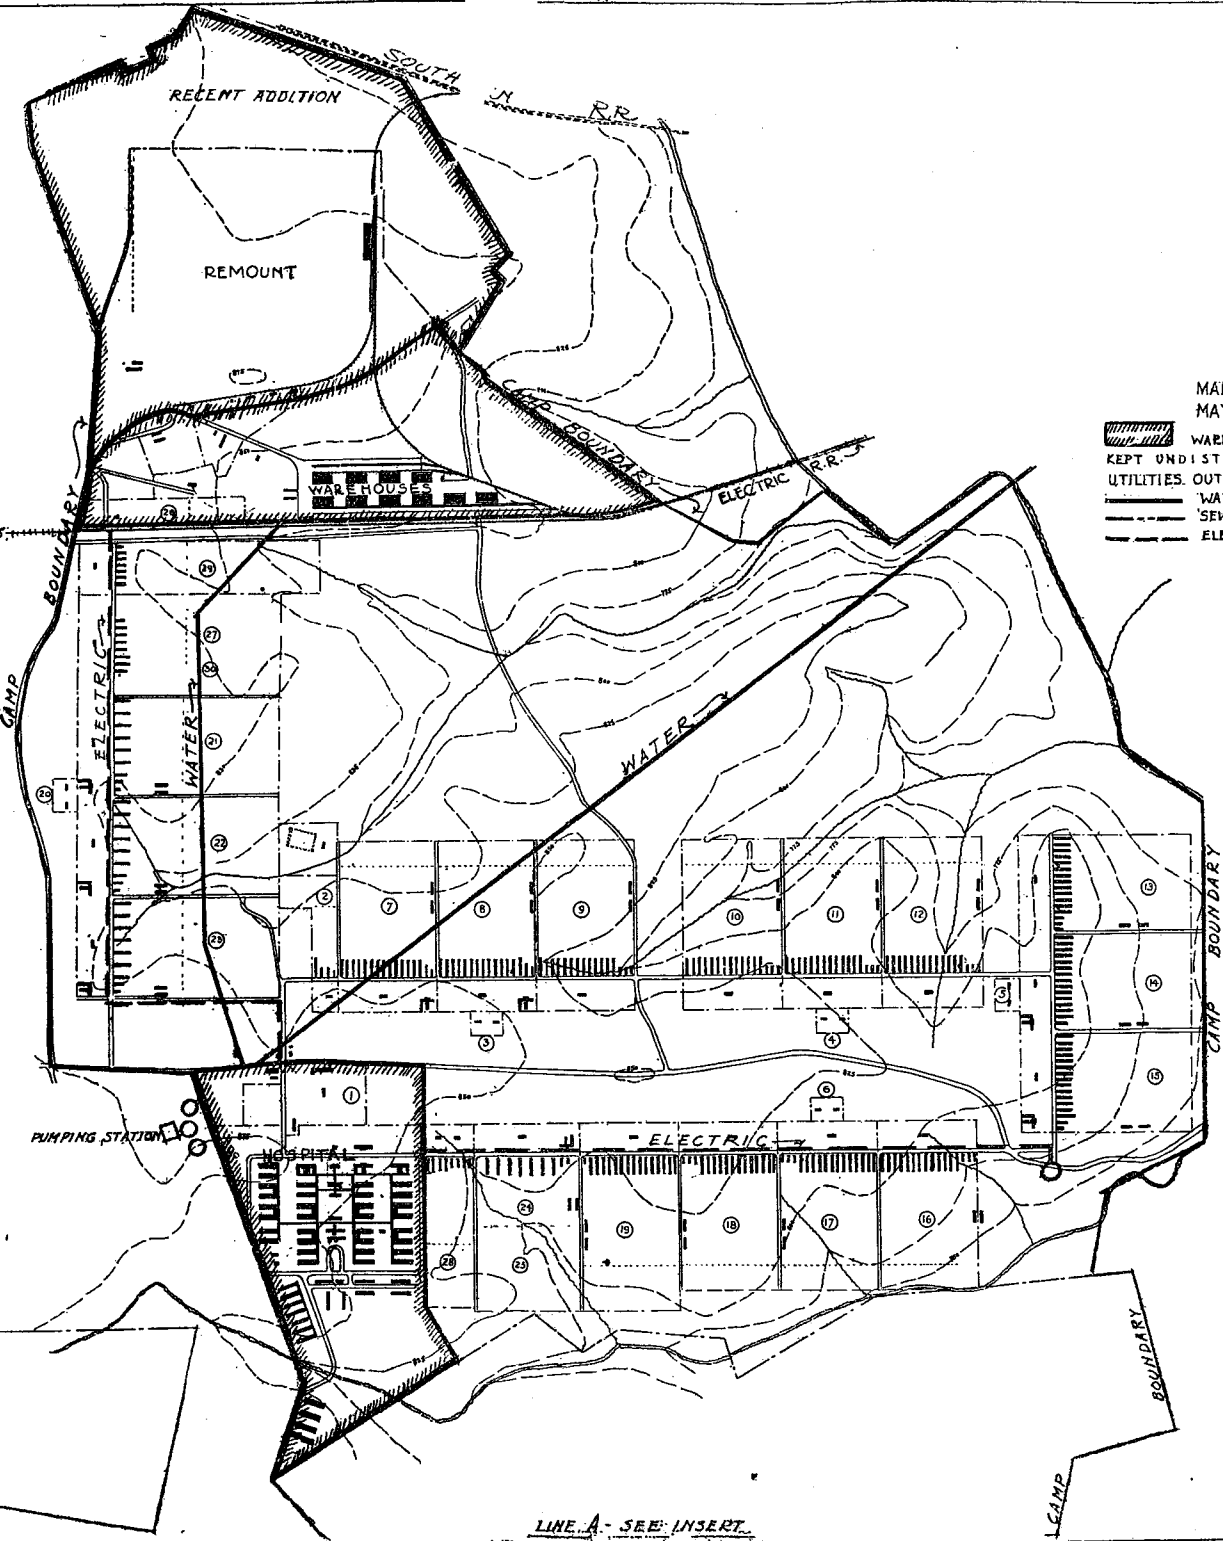


RIFLE AND ARTILLERY RANGE ABOUT 22 MILES N.W. OF DIVISION HEADQUARTERS.

Not a part of this contract

W.M. Couper

W.M. COUPER,
LT. COL., Q. M. CORPS.

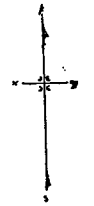

1 INCH = 370 FT
SCALE - IN - FEET

CONSTRUCTION DIVISION, WAR DEPT - WASHINGTON, D.C.
CAMP WADSWORTH - S.C.
PLAN FOR RECONSTRUCTION

JOB NO 6131 DATE MAY 9, 1918
PLAN NO 84 MAJOR QMCNA


LINE A - SEE INSERT.

9-12-15 MK

NARA-CP

RG 92

E 1998

Bx 733

Camp Wadsworth