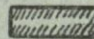
 
 



KEY FOR ONE PERSHING DIVISION



UNIT	REQUIRED AND FURNISHED	FURNISHED AND NOT REQUIRED	REQUIRED AND NOT FURNISHED
1 DIVISION HEADQUARTERS	1		
2 FIELD SIGNAL BATTALION	1		
3-6 INFANTRY BRIGADE HEADQTRRS	2	2	
7-9 INFANTRY REGIMENTS	4	9	
DIVISION MACHINE GUN BATTALION			1
BRIGADE MACHINE GUN BATTALION			2
TRENCH MORTAR BATTERY			1
20 ARTILLERY BRIGADE HEADQTRRS	1		
21-22 LIGHT ARTILLERY REGIMENTS	2		
23 HEAVY ARTILLERY REGIMENTS	1		
24 ENGINEERS REGIMENT	1		
25 ENGINEERS TRAIN	1		
26 HEADQTRRS MILITARY POLICE	1		
27 AMUNITION TRAIN	1		
28 SANITARY TRAIN	1		
29 SUPPLY TRAIN	1		
30 MOBILE ORDNANCE REPAIR SHOP	1		

MARCH 1919.

MAP REVISED TO SHOW FEATURES THAT MAY BE RESERVED FOR GOVERNMENT USE.

-  WAREHOUSE, HOSPITAL, AND REMOUNT AREAS THAT ARE TO BE KEPT UNDISTURBED IF RETAINED, AND FOR WHICH NECESSARY UTILITIES OUTSIDE THE AREAS ARE TO BE PRESERVED.
-  WATER LINES - SERVING AREAS
-  SEWER " " "
-  ELECTRIC LINES " " "

RIFLE AND ARTILLERY RANGE
ABOUT 22 MILES N.W. OF
DIVISION HEADQUARTERS

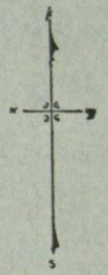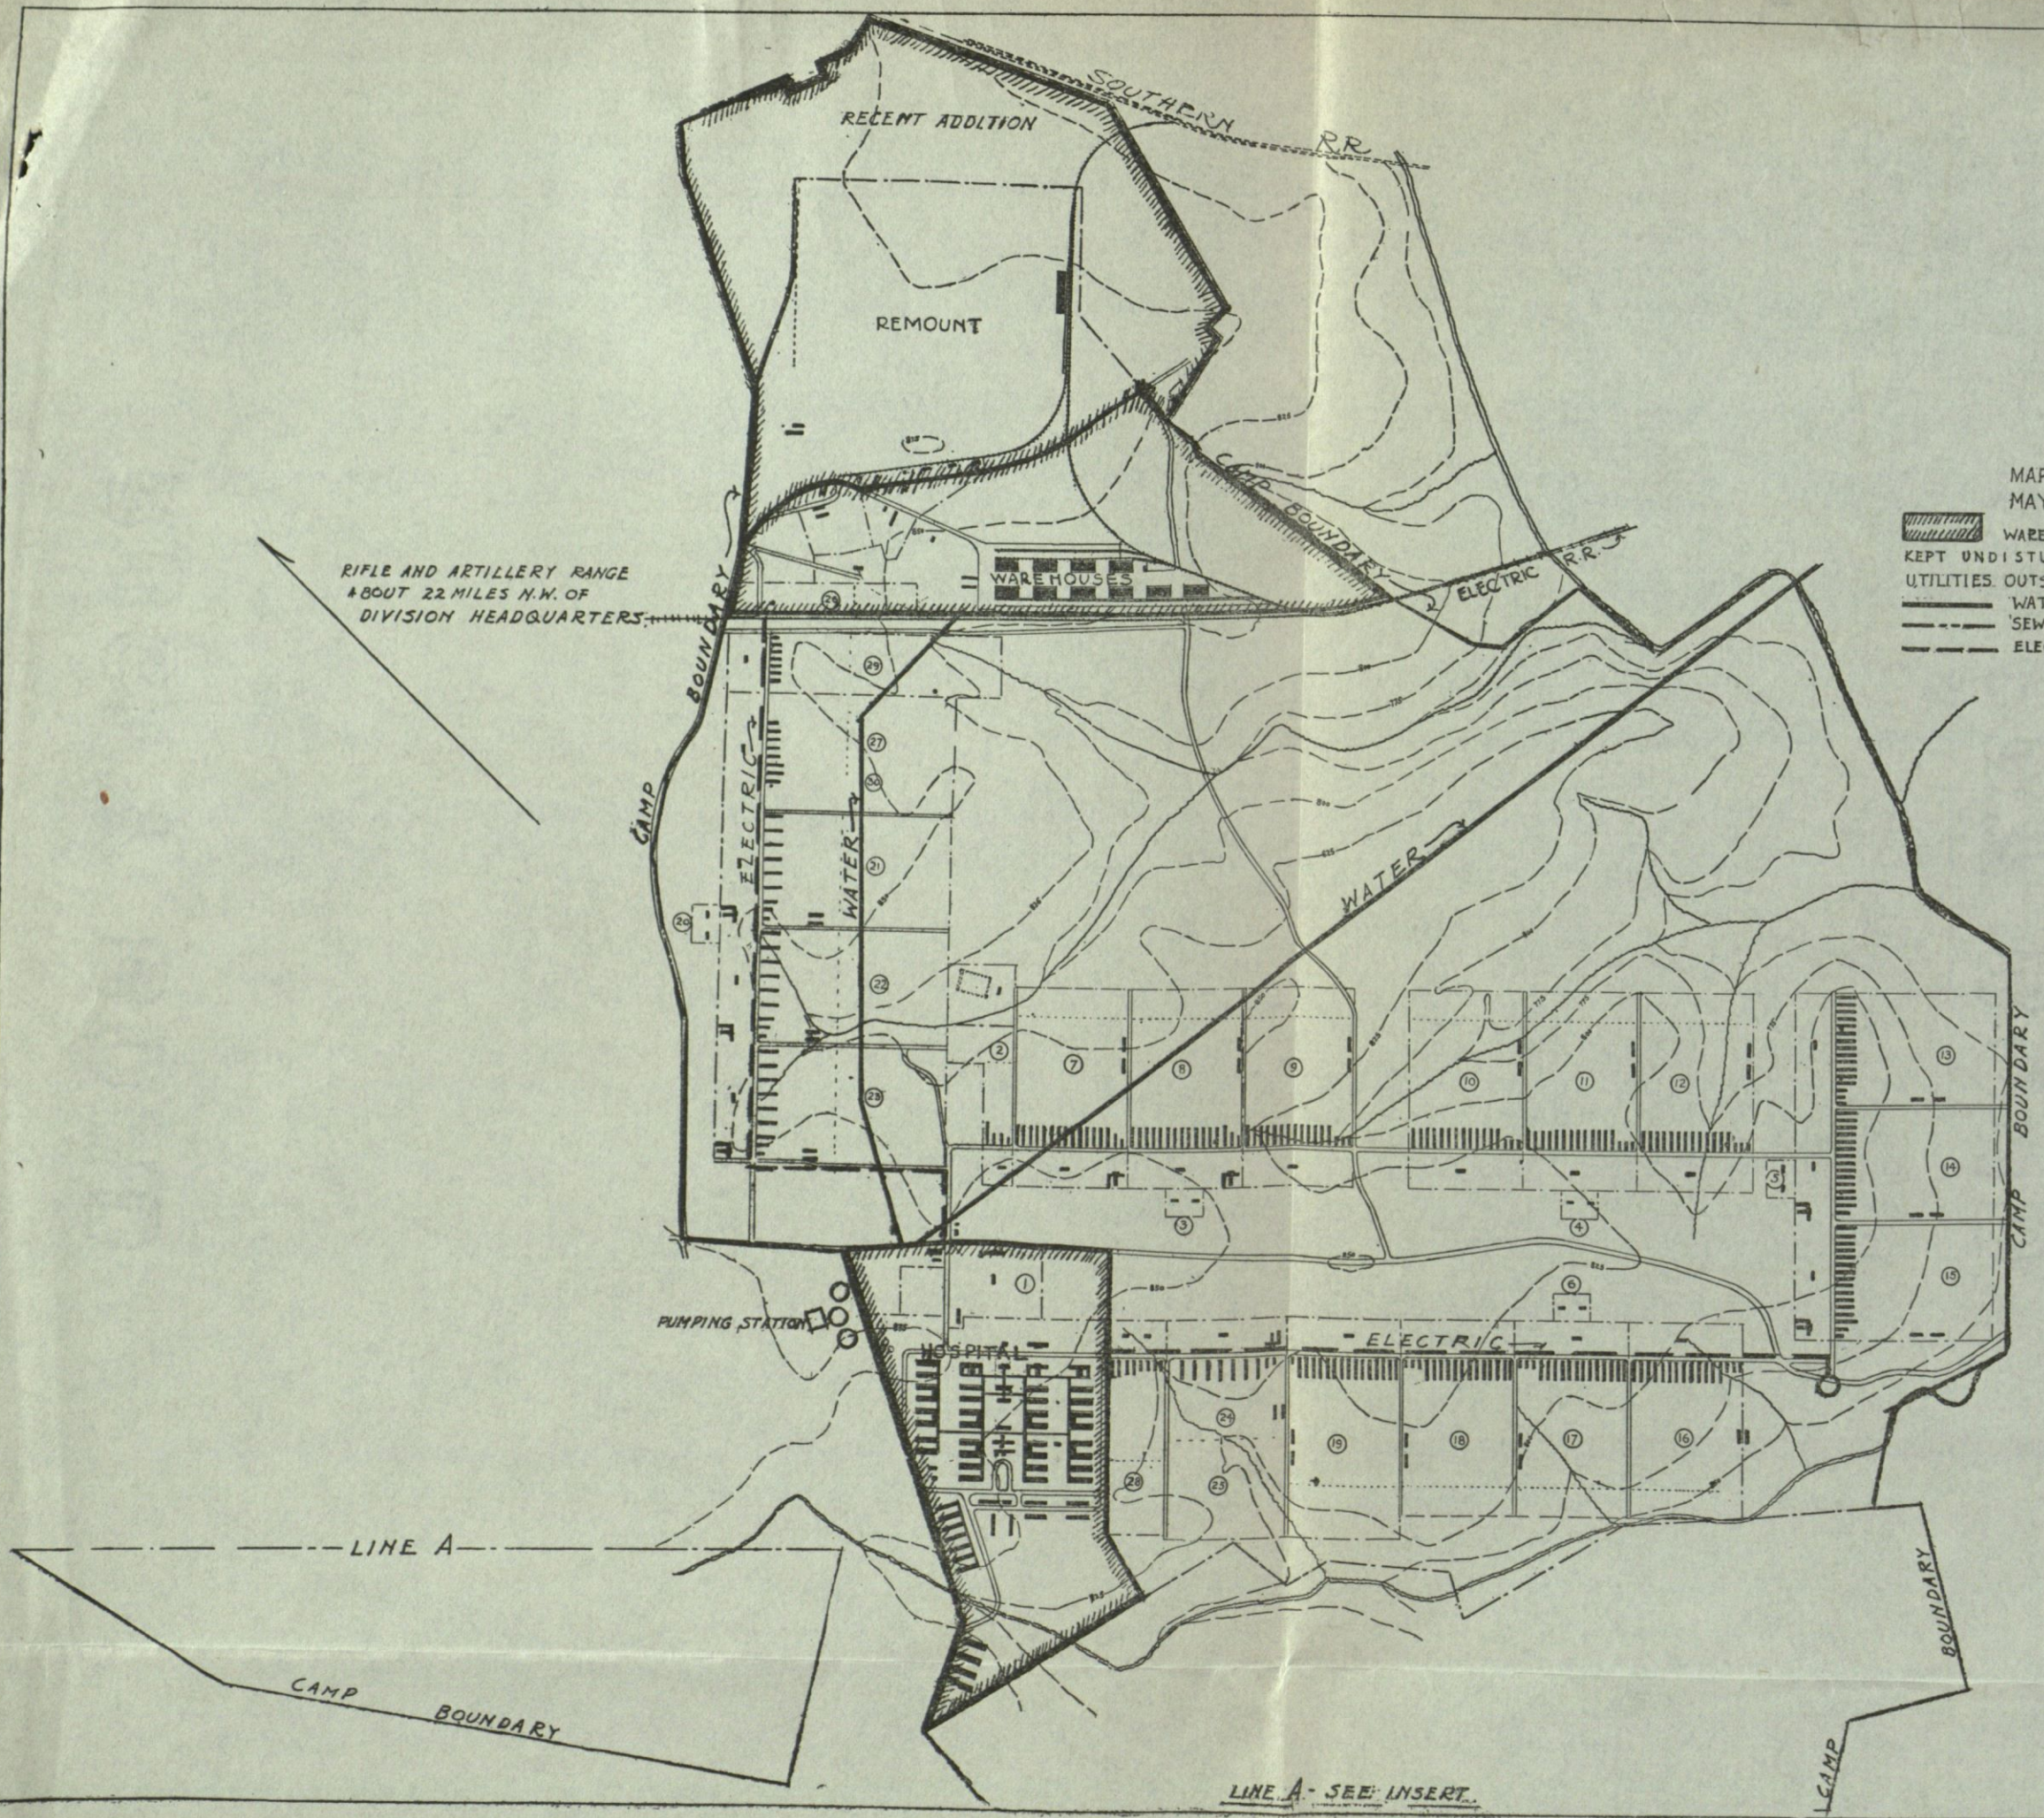

1 INCH = 370 FT
SCALE - IN - FEET

CONSTRUCTION DIVISION, WAR DEPT - WASHINGTON, D.C.
CAMP WADSWORTH - S.C.
PLAN FOR RECONSTRUCTION

JOB NO 6131 DATE MAY 9 1918
PLAN NO 84 APPROVED BY MAJOR QMCNA

DATE	REVISIONS	INSP BY	APPROVED

DESIGNED BY DRAWN BY CHECKED BY INSPECTED BY NUMBER
910 H. Hall 6131-84

LINE A - SEE INSERT.