


PROP. RW  
HENDRIX

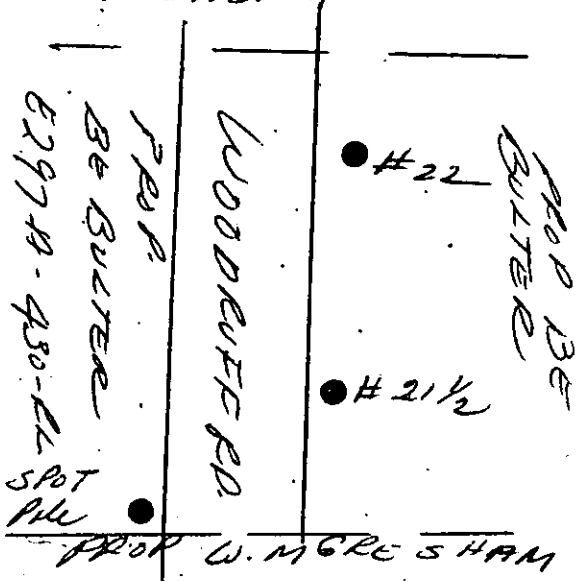

Name and Post Office Address of Grantor: B. E. Butler  
Box 1 Greenville S.C.

Toll Line \_\_\_\_\_ (Name)  
 Or Exchange Line Greenville S.C. (Exchange)  
 tributary to \_\_\_\_\_

The Property is bounded where the line enters and leaves this property by the property of:  
B. E. Butler on the W and W. M. Greesham on the E

The poles (or stakes) have the following identification:  
E 2 1/2 to E 22

Authority: RS 2309 Classification: 9-C

Area: Greenville S.C.

Approved: [Signature]

Title: Super Eas.

NORTH

GENERAL PERMIT

Received of the SOUTHERN BELL TELEPHONE AND TELEGRAPH COMPANY one dollar and no /100 Dollars in consideration of which (I) [Signature] hereby grant said Company, its associated and allied companies, their respective licensees, successors and assigns, the right to construct, operate and maintain a line of communication consisting of such poles, wires, cables, conduits, guys, anchors and other necessary appurtenances as from time to time are required upon, across, over and/or under that certain tract of land situated in Greenville County, State of South Carolina, to-wit:

that this permit covers that tract of land along Woodruff Rd. bounded on east by property of W. M. Greesham and bounded on west by property of R. W. Hendrix

and upon, along and under the roads, streets, or highways adjoining or through said property with the right to permit the attachment of and/or carry in conduit wires and cables of any other person or company for communications purposes or for the transmission and distribution of electric power and the right of ingress and egress to said premises at all times for the purpose of inspecting and maintaining said line and with the right to clear and keep cleared all trees, undergrowth or other obstructions within a strip of land 10 feet on each side of the center of said line and to trim and cut and keep trimmed and cut all dead, weak, leaning or dangerous trees which might reach said line in falling; including the right to relocate said line on said premises to conform to any future highway relocation, widening or improvement; the said sum being received in full payment for the rights herein granted.

Signed, sealed and delivered in the presence of: 27957 Executed Oct 24, 19 56

[Signature] B. E. Butler (SEAL)

[Signature] B. E. BUTLER (RW) (SEAL)

ACKNOWLEDGMENTS

For Use in South Carolina

Individual Form

STATE OF SOUTH CAROLINA }  
 COUNTY OF Greenville } ss.

Personally appeared before me R. I. Brown  
 and made oath that (he) (she), with Dwain Powell saw the within named B. E. Butler

sign, seal, and deliver as (his) (her) (their) act and deed the within written instrument, and that (he) (she) with the said Dwain Powell witnessed the execution thereof.

Sworn to before me this 24 day of Oct, A.D. 195 6

[Signature] Notary Public Recorded November 7th, 1956 at 9:00 A.M. #27957