


N

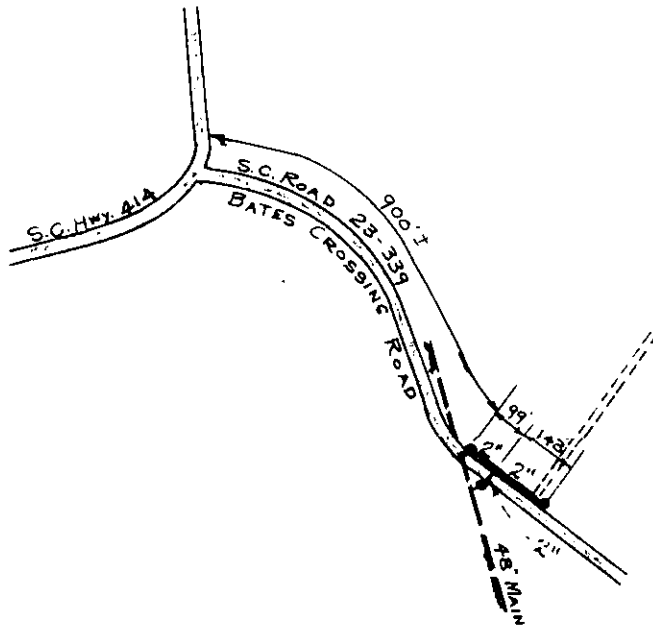

Material

- 274' ± 2" Galv. Pipe
- 3 2" Valves

MRS. MYRTLE S. CHILDS
TO
CITY OF GREENVILLE, S. C.

GREENVILLE WATER WORKS
Scale 1" = 400' 9-15-64

Recorded September 21st., 1964 At 9:48 A.M. # 8622