


Scale 1" = 400'

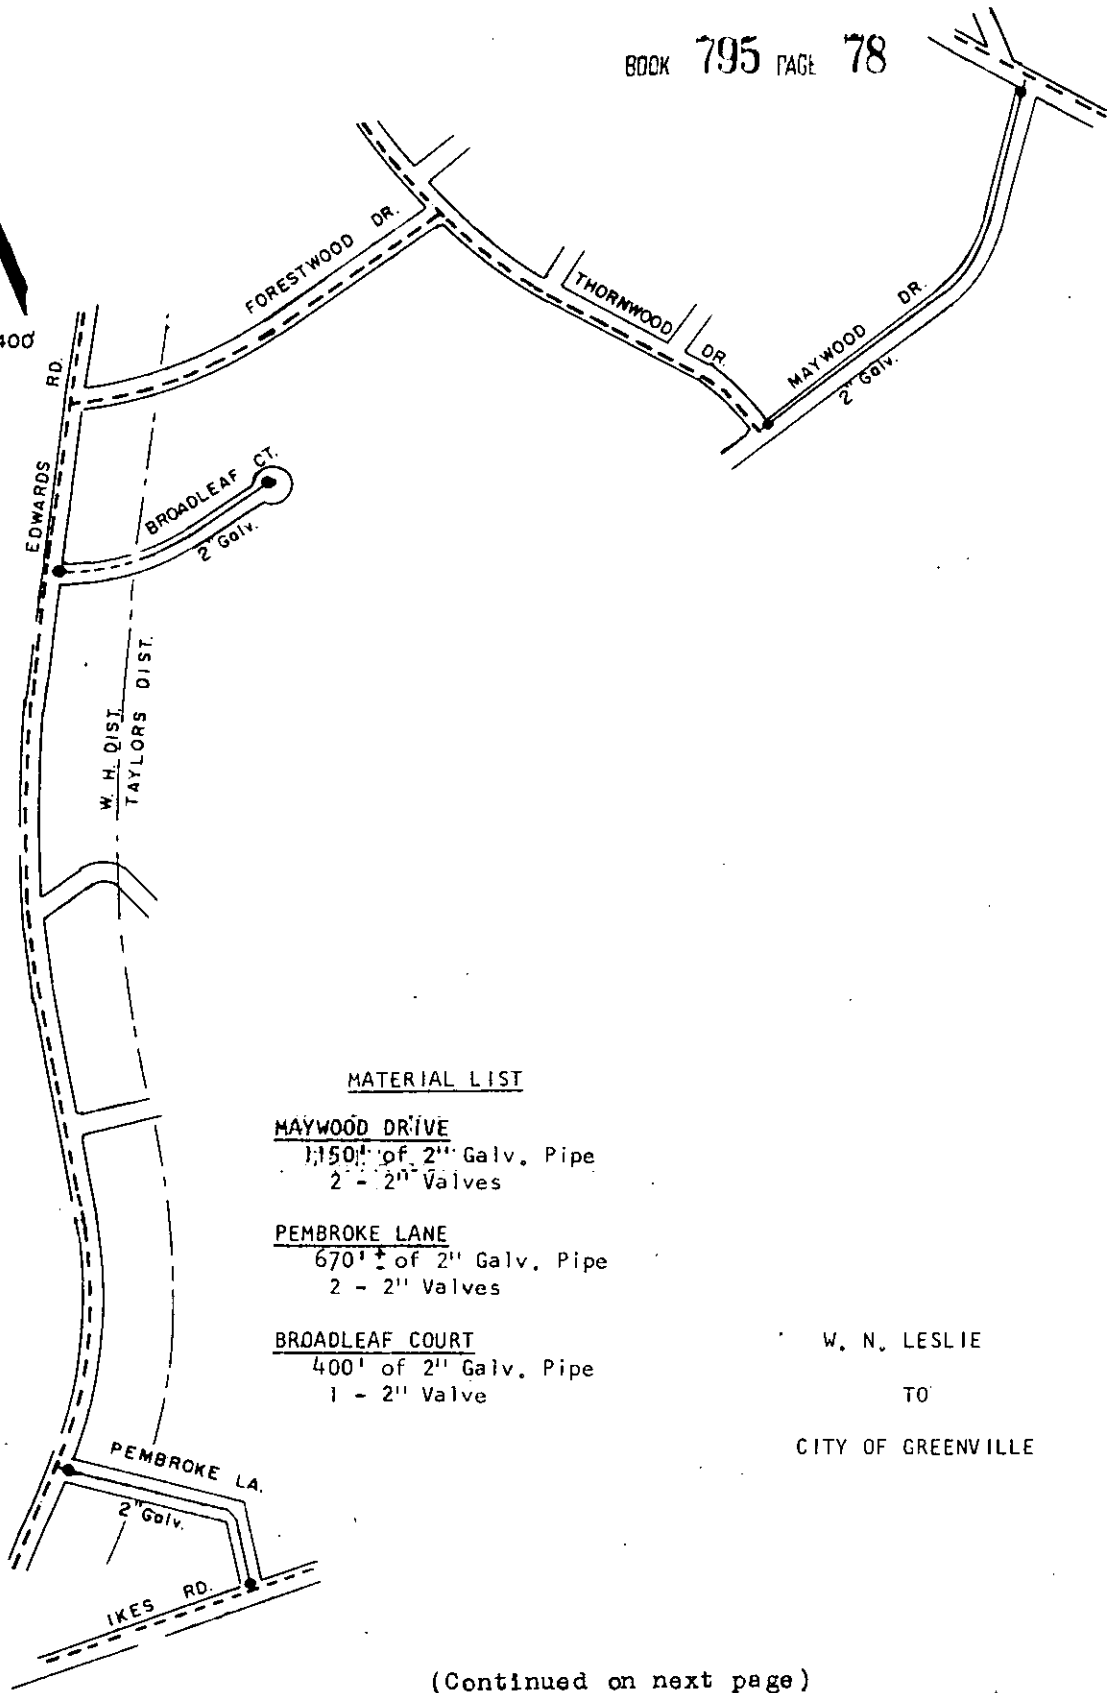

MATERIAL LIST

MAYWOOD DRIVE

1150' of 2" Galv. Pipe
2 - 2" Valves

PEMBROKE LANE

670' of 2" Galv. Pipe
2 - 2" Valves

BROADLEAF COURT

400' of 2" Galv. Pipe
1 - 2" Valve

W. N. LESLIE

TO

CITY OF GREENVILLE

(Continued on next page)