


Material List

- 7582' of 6" C. I. Pipe
- 13 - 6" Valves & Boxes
- 5 - Fire Hydrants
- 2170' of 2" Galv. Pipe
- 7 - 2" Valves & Boxes

W. Bernard Simmons
 To
 City Of Greenville

40

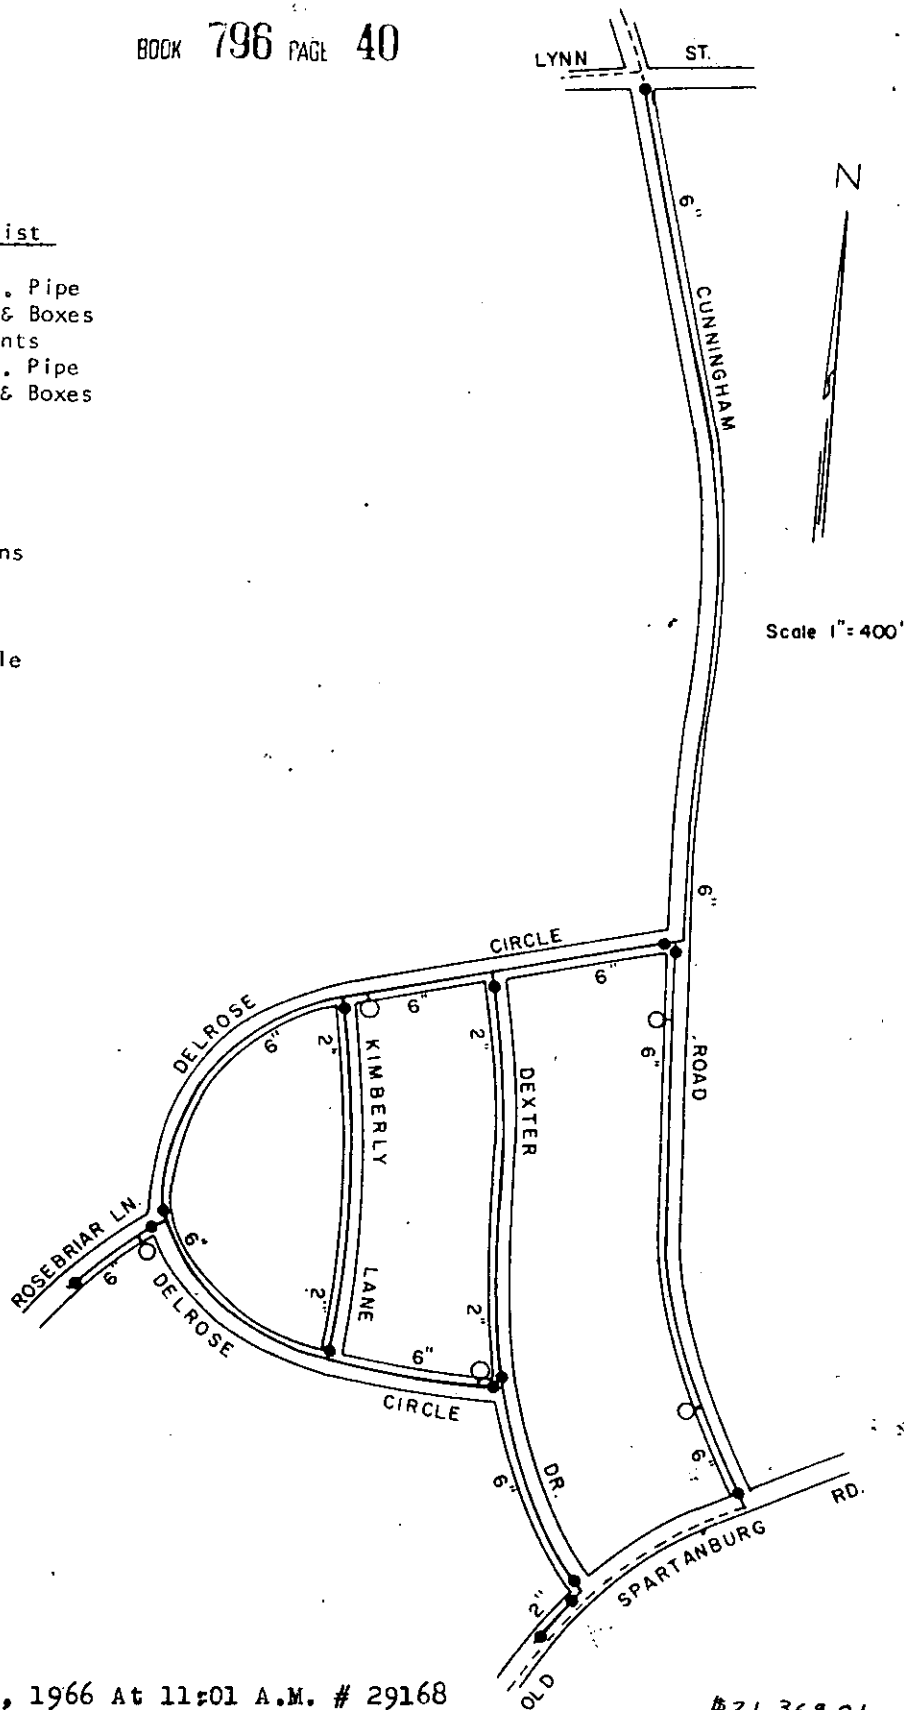

Recorded April 11th., 1966 At 11:01 A.M. # 29168

\$21,369.01