


1.00 X 7

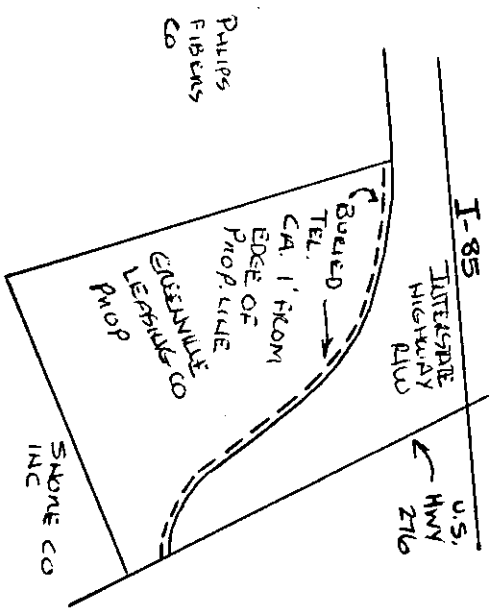

PHILIPS
FIBERS
CO

Name and Post Office Address of Grantor: **JUN 21 1967**
GREENVILLE LEASING CO
611 LEXINGTON WAY
GREENVILLE, S.C.

Toll Line: _____ (Name)
 Exchange Line: **GREENVILLE** (Exchange)
 Tributary to: _____

The Property is bounded where the line enters and leaves this property by the property of:
U.S. HWY 216 on the **EAST** and **PHILIPS FIBERS CO** on the **WEST**

The poles (or stakes) have the following identification:
 Authority: **73-6002** Classification: **45-C**
 Area: **GREENVILLE**
 Approved: *[Signature]*
 Title: *[Signature]*
 NORTH

GEP 47.101 **31324** **GENERAL PERMIT** (CORPORATION) Form 8417 Nov. '64

Received of the **SOUTHERN BELL TELEPHONE AND TELEGRAPH COMPANY ONE AND** 80 /100 Dollars, in consideration of which **GREENVILLE LEASING COMPANY** hereby grants said Company, its associated and allied companies, their respective licensees, successors and assigns, the right to construct, operate and maintain a line of communication consisting of such poles, wires, cables, conduits, guys, anchors and other necessary appurtenances as from time to time are required upon, across, and/or under that certain tract of land situated in **GREENVILLE** County, State of **SOUTH CAROLINA**, to-wit: **THAT PROPERTY BOUNDED ON THE NORTH BY I-85, ON THE EAST BY US 216, ON THE SOUTH BY SHORE CO. INC. PROPERTY, ON THE WEST BY PHILIPS FIBERS CO. PROPERTY** and upon, along and under the roads, streets, or highways adjoining or through said property with the right to permit the attachments of and/or carry in conduit wires and cables of any other person or company for communications purposes or for the transmission and distribution of electric power and the right of ingress and egress to said premises at all times for the purpose of inspecting and maintaining said line and with the right to clear and keep cleared all trees, undergrowth or other obstructions within a strip of land 5 feet on each side of the center of said line and to trim and cut and keep trimmed and cut all dead, weak, leaning or dangerous trees which might reach said line in falling; including the right to relocate said line on said premises to conform to any future highway relocation, widening or improvement; the said sum being received in full payment for the rights herein granted.

IN WITNESS WHEREOF, the said grantor has caused its name to be hereunto set and its seal hereunto affixed this 21 day of June, 1967
 Signed, sealed and delivered in the presence of:
[Signature] By *[Signature]* **Greenville Leasing Co.**
[Signature] **Pres't**
 Attest: *[Signature]*
 (Corporate Seal)

Corporation Form

STATE OF SOUTH CAROLINA } ss.
 COUNTY OF Greenville }
 Personally appeared before me *[Signature]*
 who, on oath, says that (he) (~~she~~), with **JAMES R SHIRLEY**, saw **WALTER W. GOLDSMITH**,
 President of the **GREENVILLE LEASING CO.**, sign and seal, and as
 the act and deed of said corporation, deliver the within written instrument, and that (he) (~~she~~), with

JAMES R. SHIRLEY witnessed the execution thereof.
[Signature]
 Sworn to and subscribed before me this 16 day of June, 1967
[Signature]
 Notary Public
 Recorded June 21, 1967 At 4:50 P.M.
 # 31324

GREENVILLE CO. S.C.
 JUN 21 4 59 PM 1967
 OLLIE F. SMITH NORTH
 R.M.E.