


TAYLOR'S FIRE DEPARTMENT

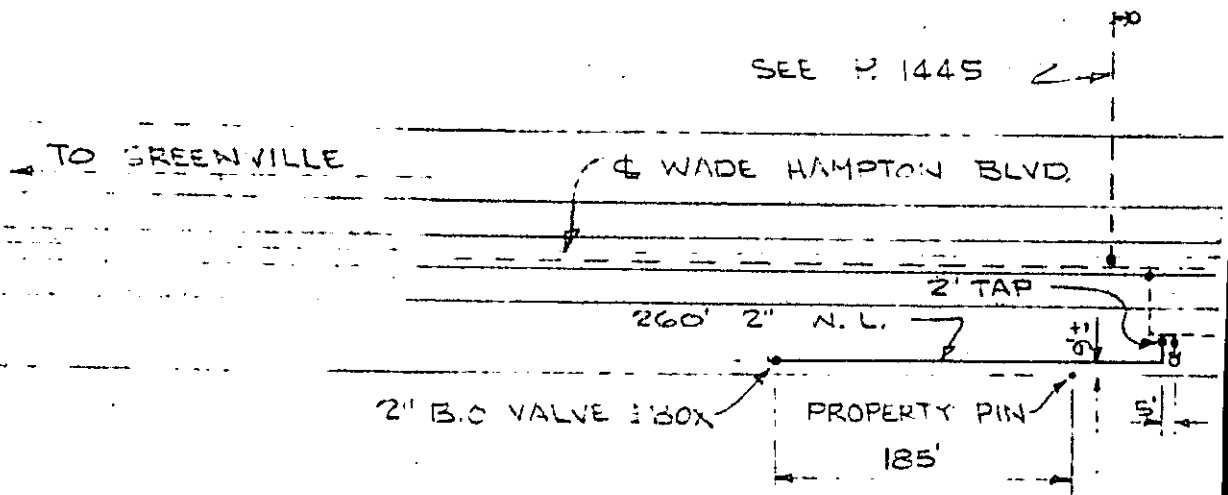

MATERIAL LIST

- 260' - 2" Galv. Pipe
- 2 - 2" Valves

L.S. Chapman and W.F. Waldrop  
D

City of Greenville, S.C.

April 17, 1968

Recorded May 30, 1968 At 9:41 A.M. # 30830