


TOWN LIMITS

BOOK 846 PAGE 34

MATERIAL LIST:

- 2759 ft. ± 6" C.I. Pipe
- 2270 ft. ± 2" Galv. Pipe
- 1 - 8" Valve
- 1 - 6" Valve
- 1 - 2" Valve

Recorded May 31, 1968 At 4:51 P.M. # 31171

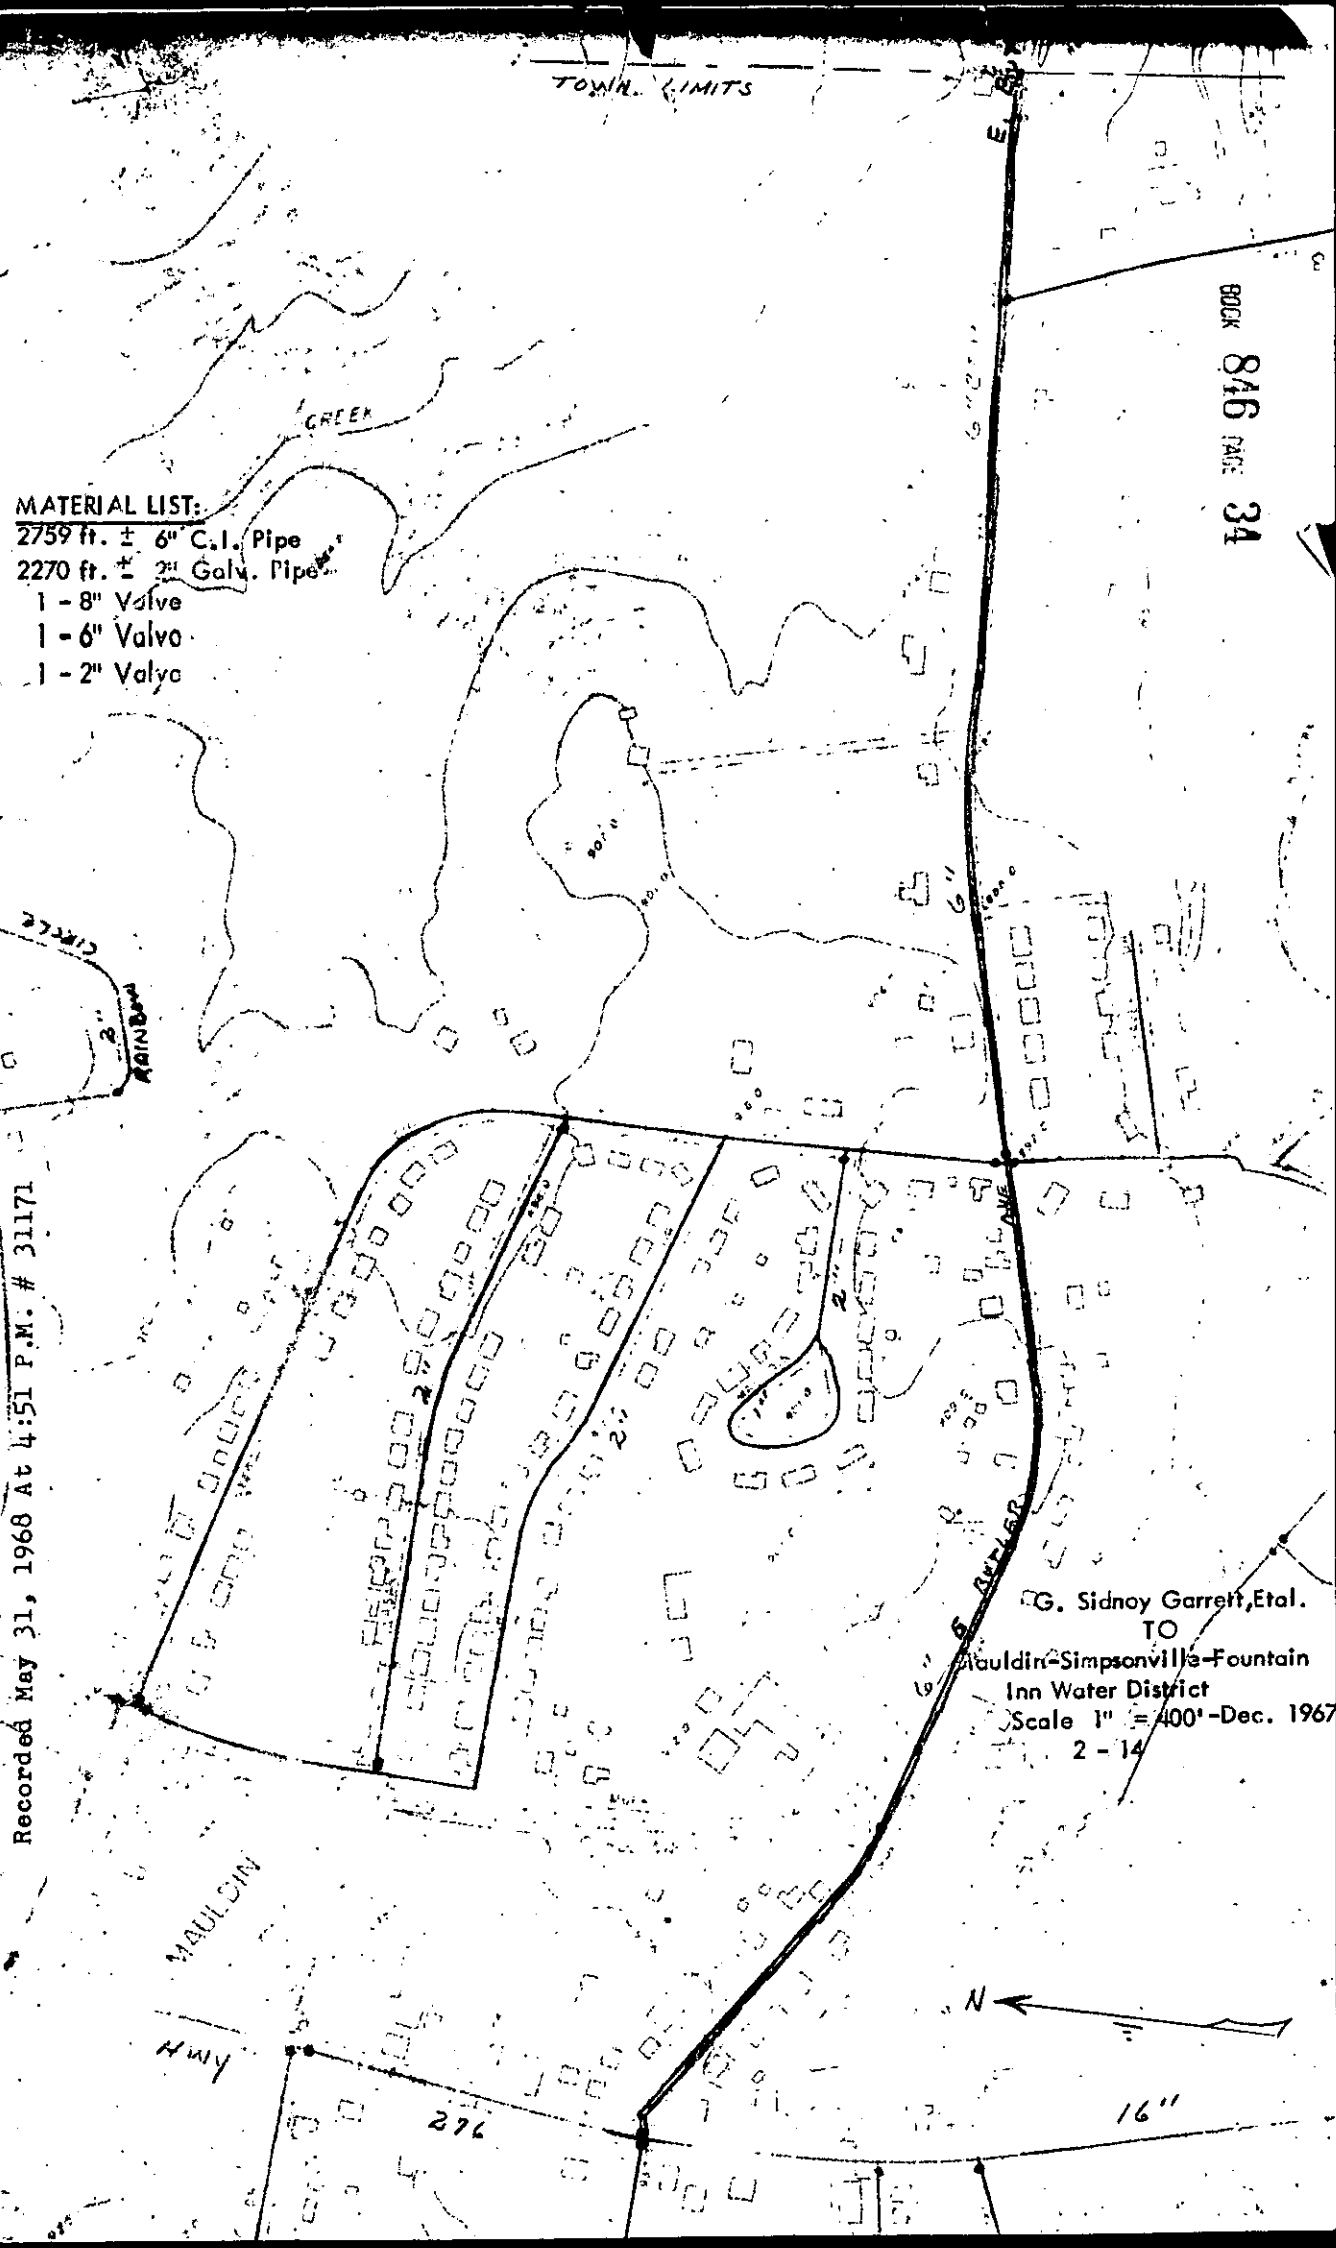

G. Sidney Garrett, Etal.
 TO
 Mauldin-Simpsonville-Fountain
 Inn Water District
 Scale 1" = 400' - Dec. 1967
 2 - 14

MAULDIN

Hwy

276

N

16"