


MATERIAL LIST:
2,336 Ft. ± 6" C.I. Pipe
837 ft. ± 3" Galv. Pipe
2 - 6" Valves

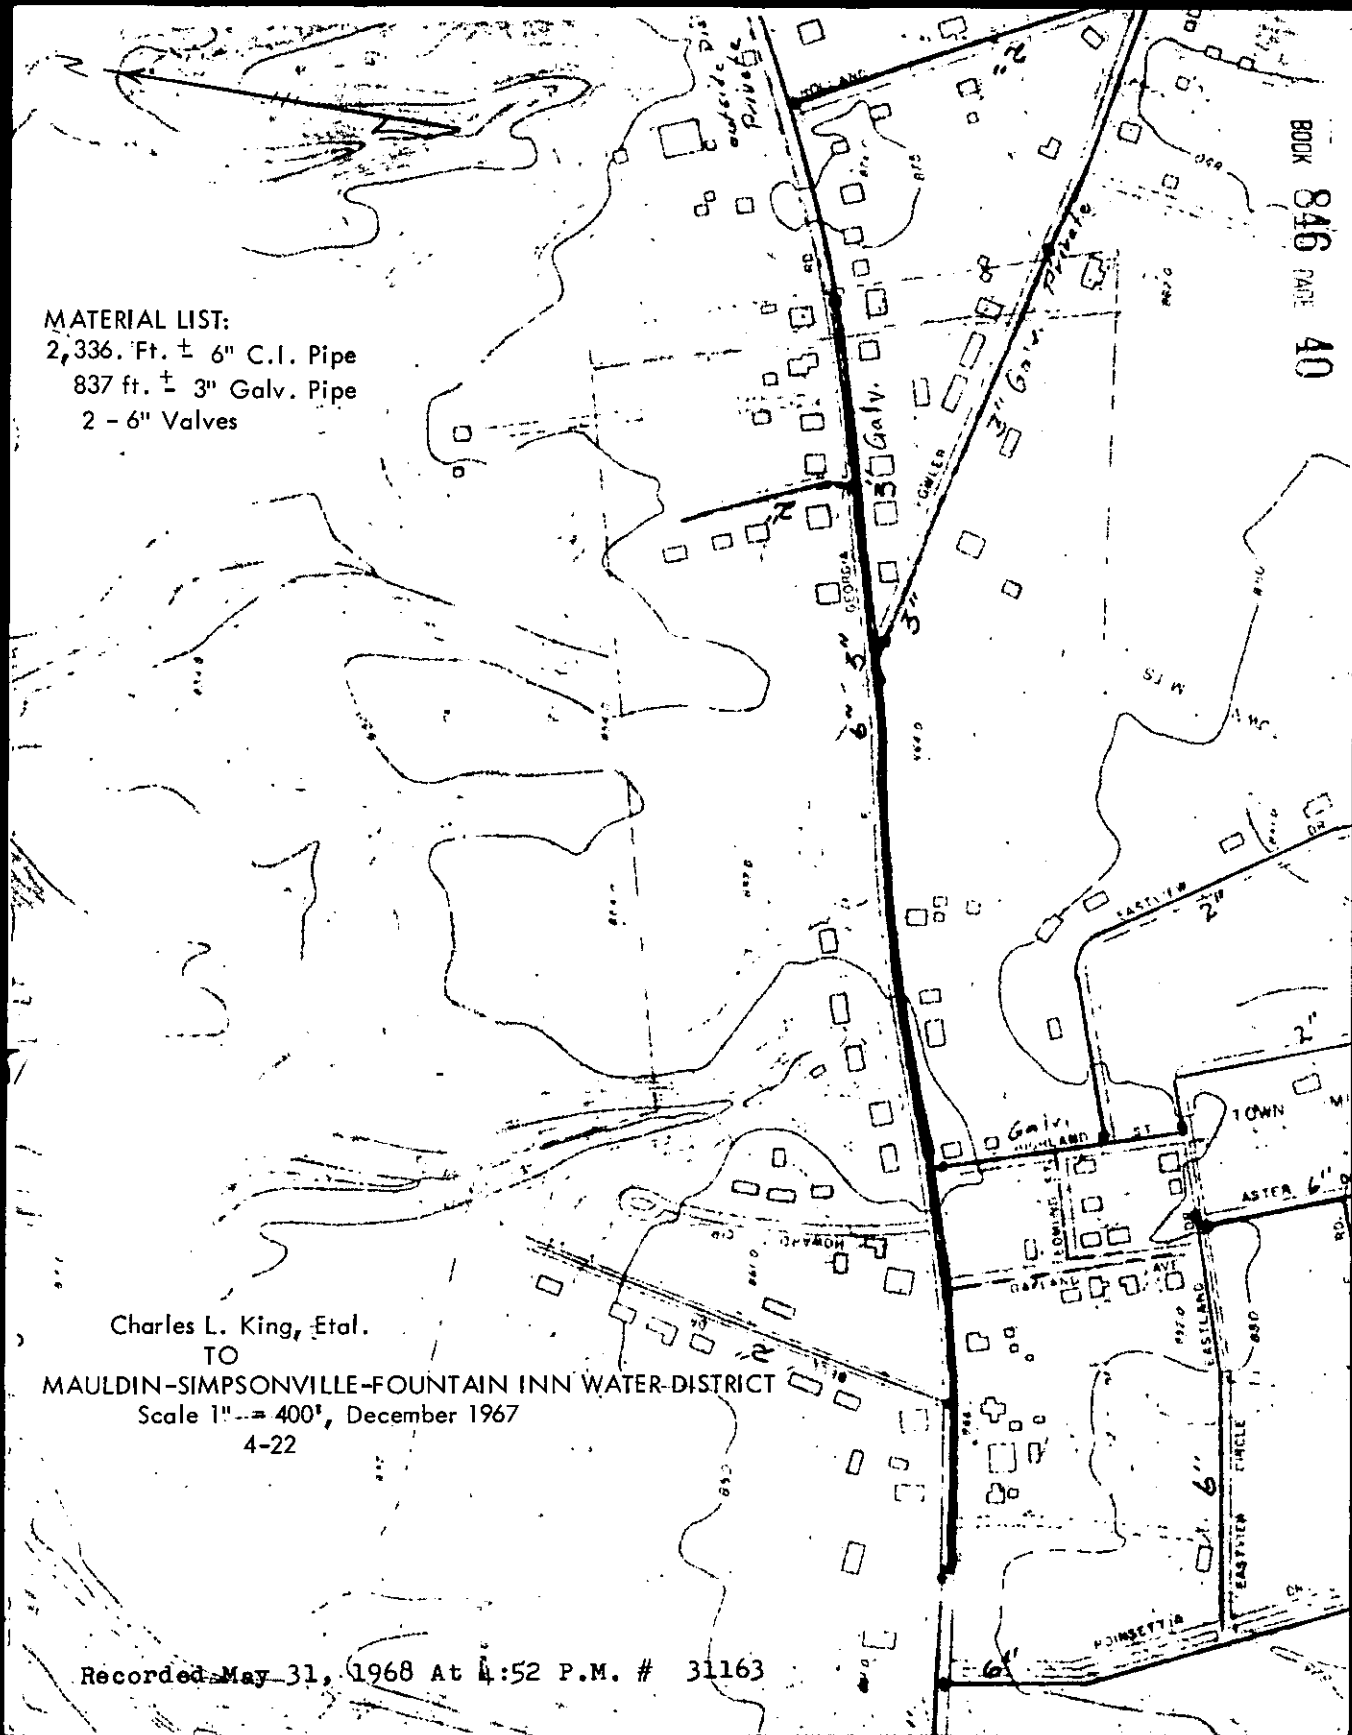

Charles L. King, Etal.
TO
MAULDIN-SIMPSONVILLE-FOUNTAIN INN WATER-DISTRICT
Scale 1" = 400', December 1967
4-22

Recorded May 31, 1968 At 4:52 P.M. # 31163