


MATERIAL LIST:
 3,200 Ft. ± 8" C.I. Pipe
 1,150 Ft. ± 6" C.I. Pipe
 890 Ft. ± 3" C.I. Pipe

Recorded May 31, 1968 At 4:53 P.M. # 31168

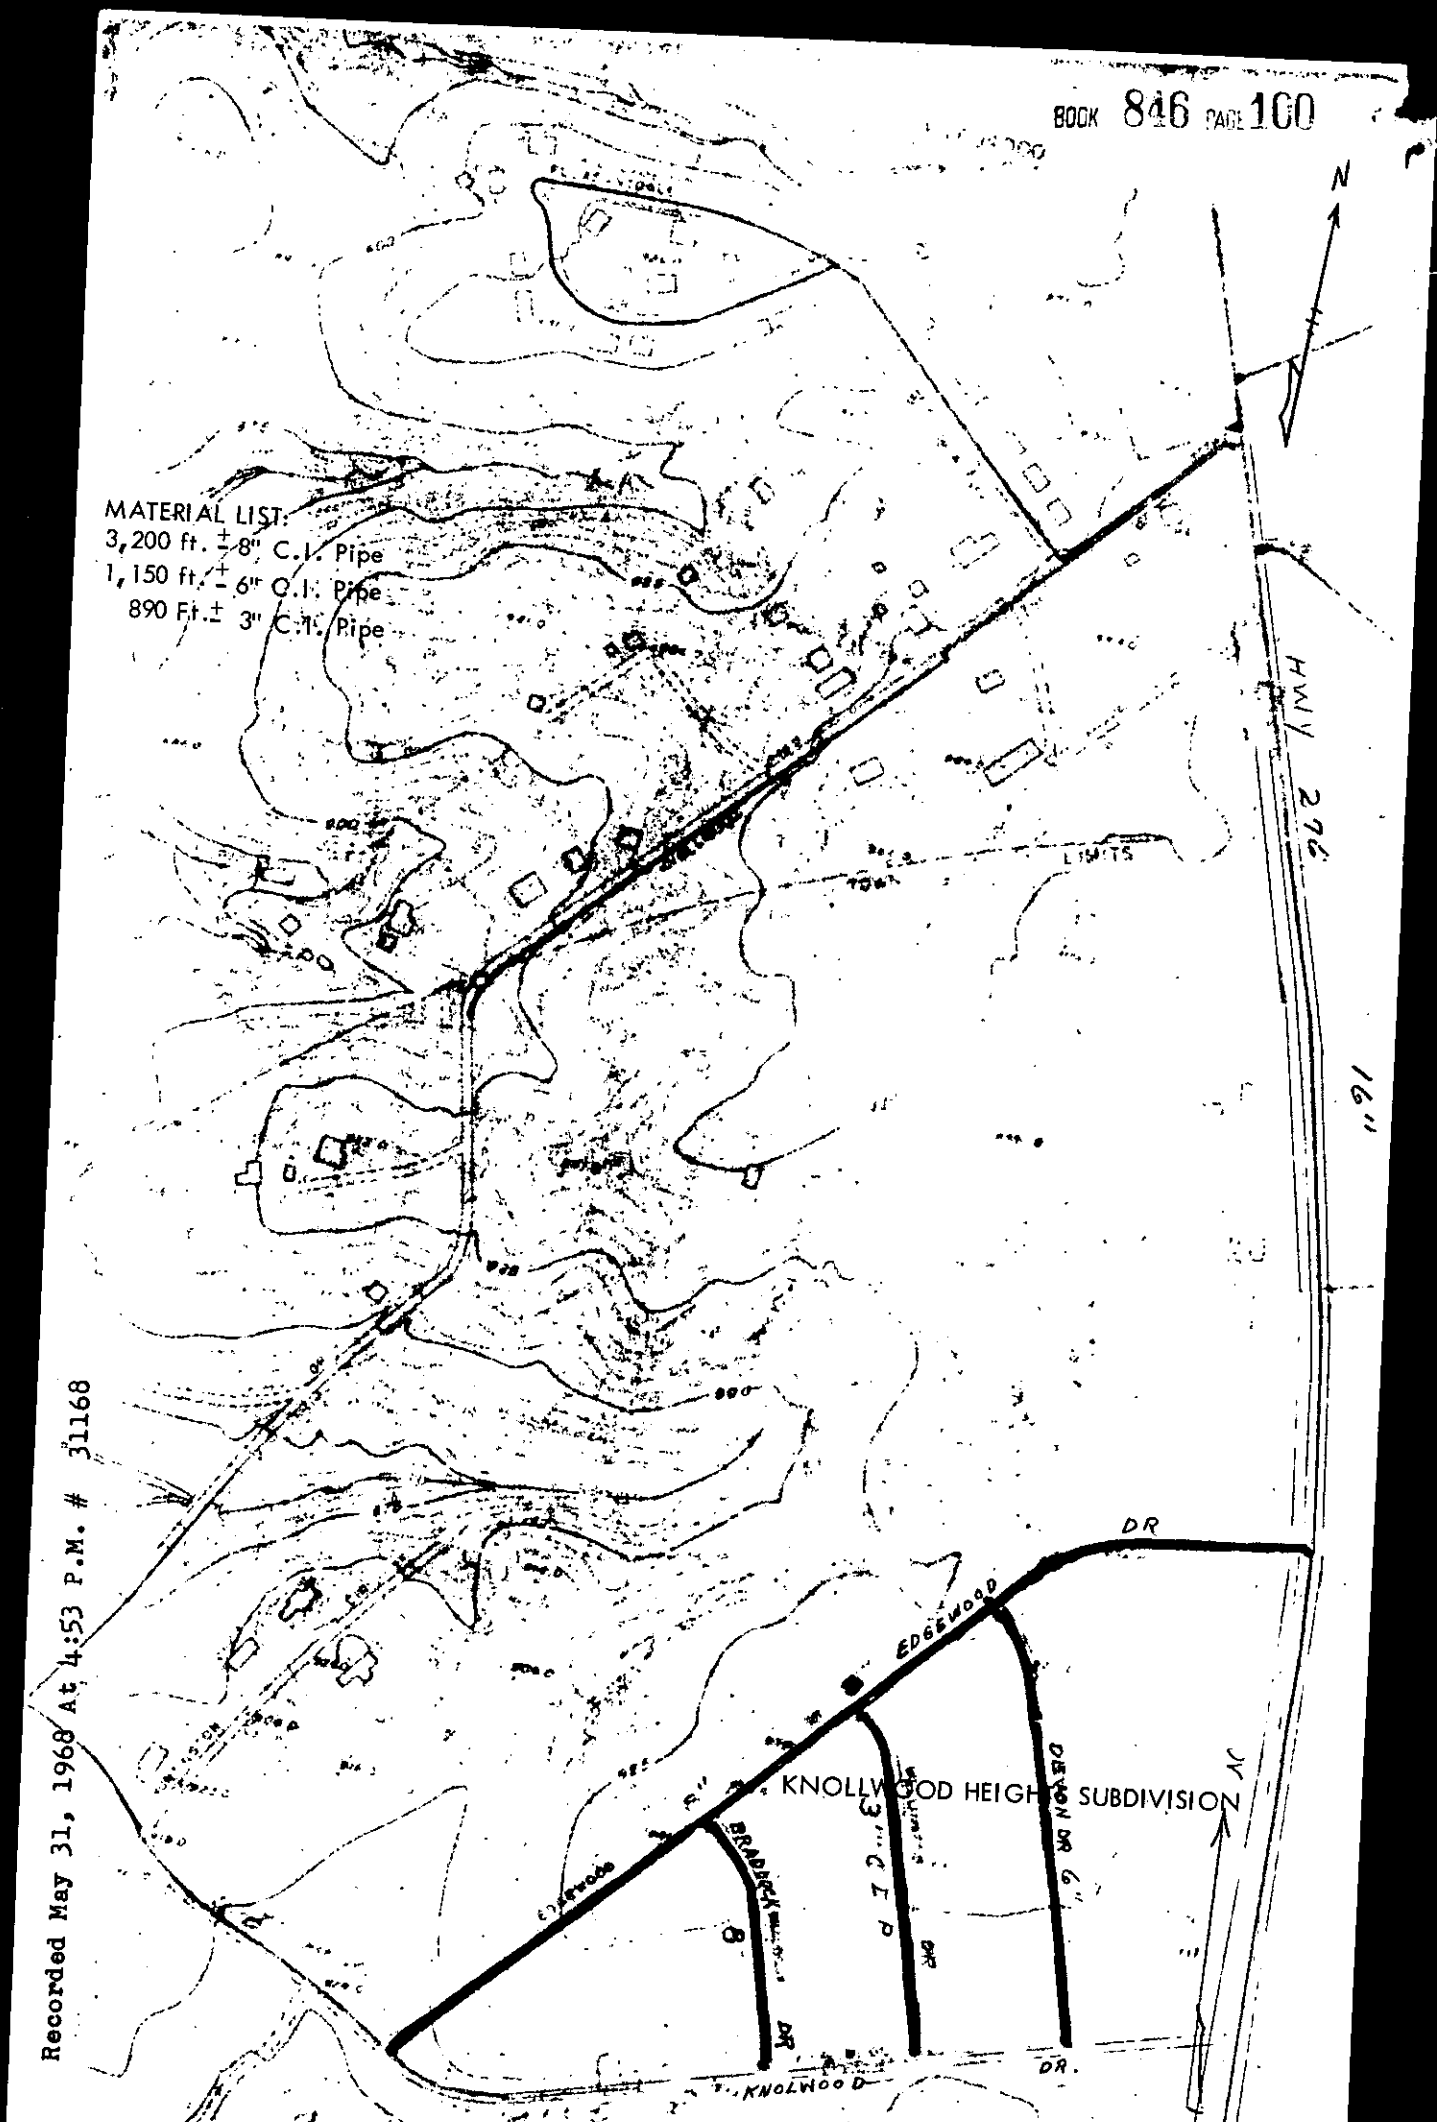

Scale 1" = 400' (Dec. 1967) W.N. Leslie, Inc. W. N. Leslie, President
 2-16 MAULDIN-SIMPSONVILLE FOUNTAIN INN WATER DISTRICT