



E1,646

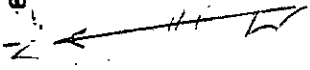

MATERIAL LIST:

- 1,014 ft. ± 2" Galv. pipe
- 2 - Valves

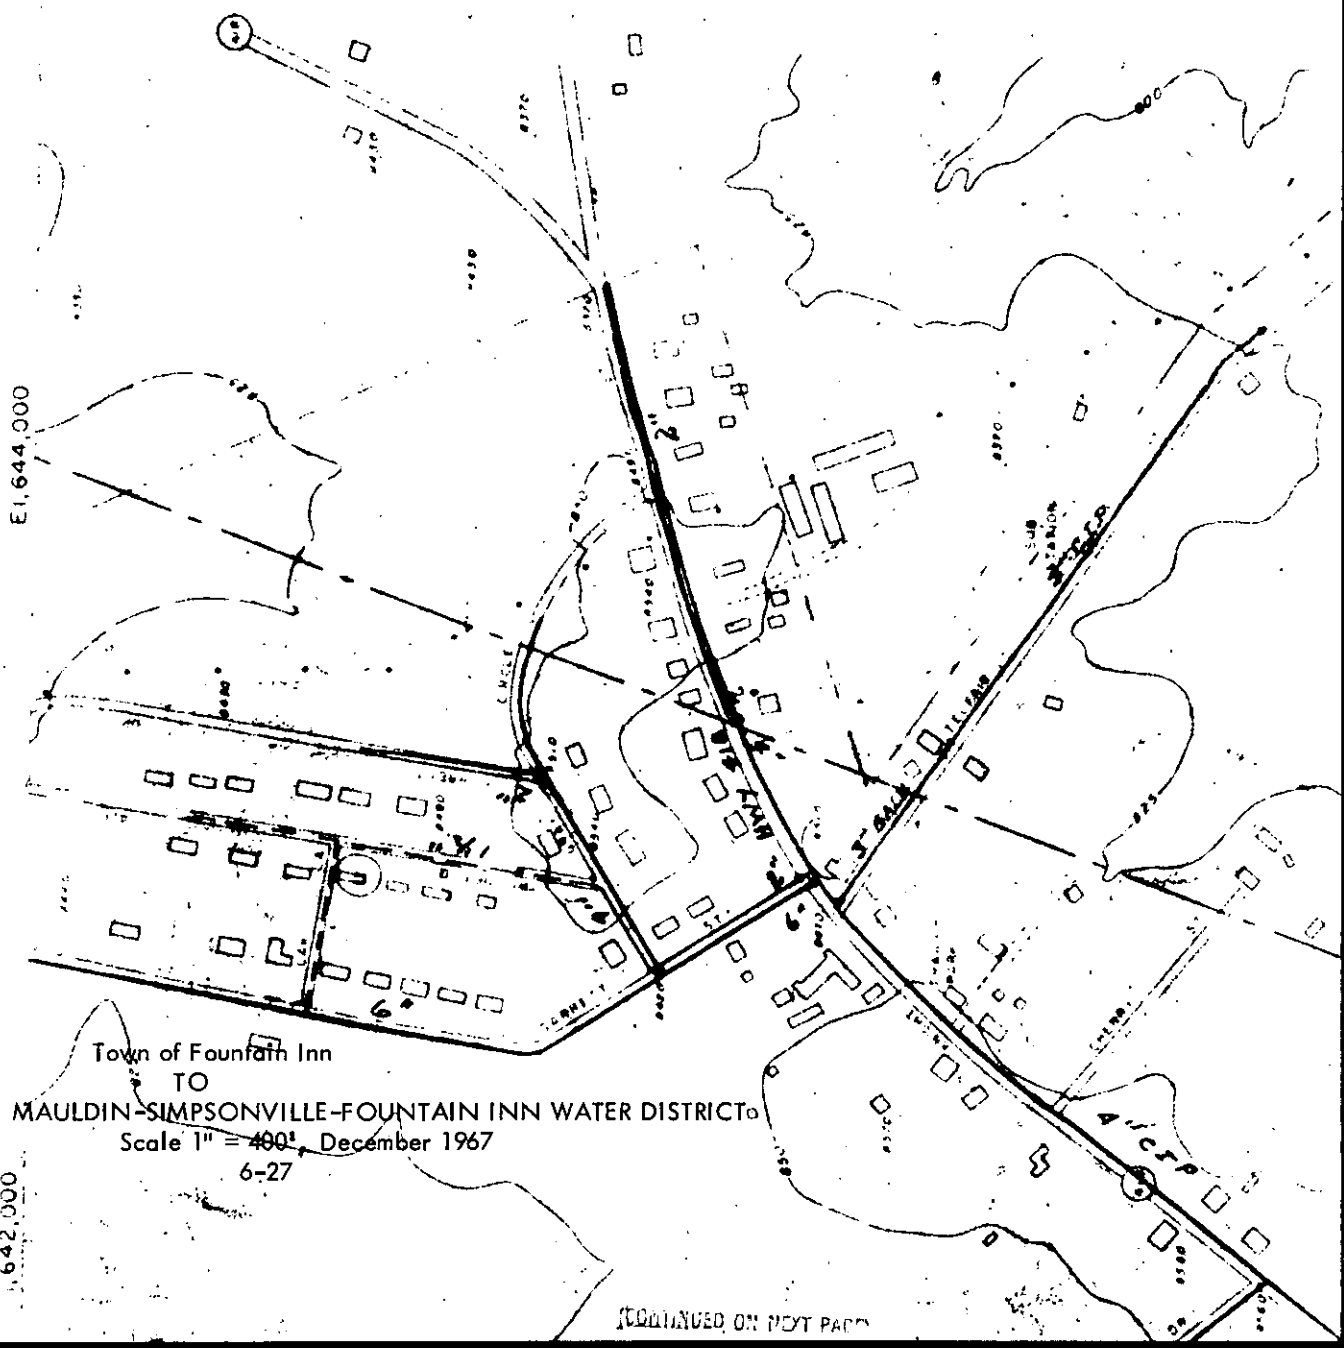

Town of Fountain Inn
 TO
 MAULDIN-SIMPSONVILLE-FOUNTAIN INN WATER DISTRICT
 Scale 1" = 400', December 1967
 6-27

CONTINUED ON NEXT PAGE

E1,642,000

E1,644,000