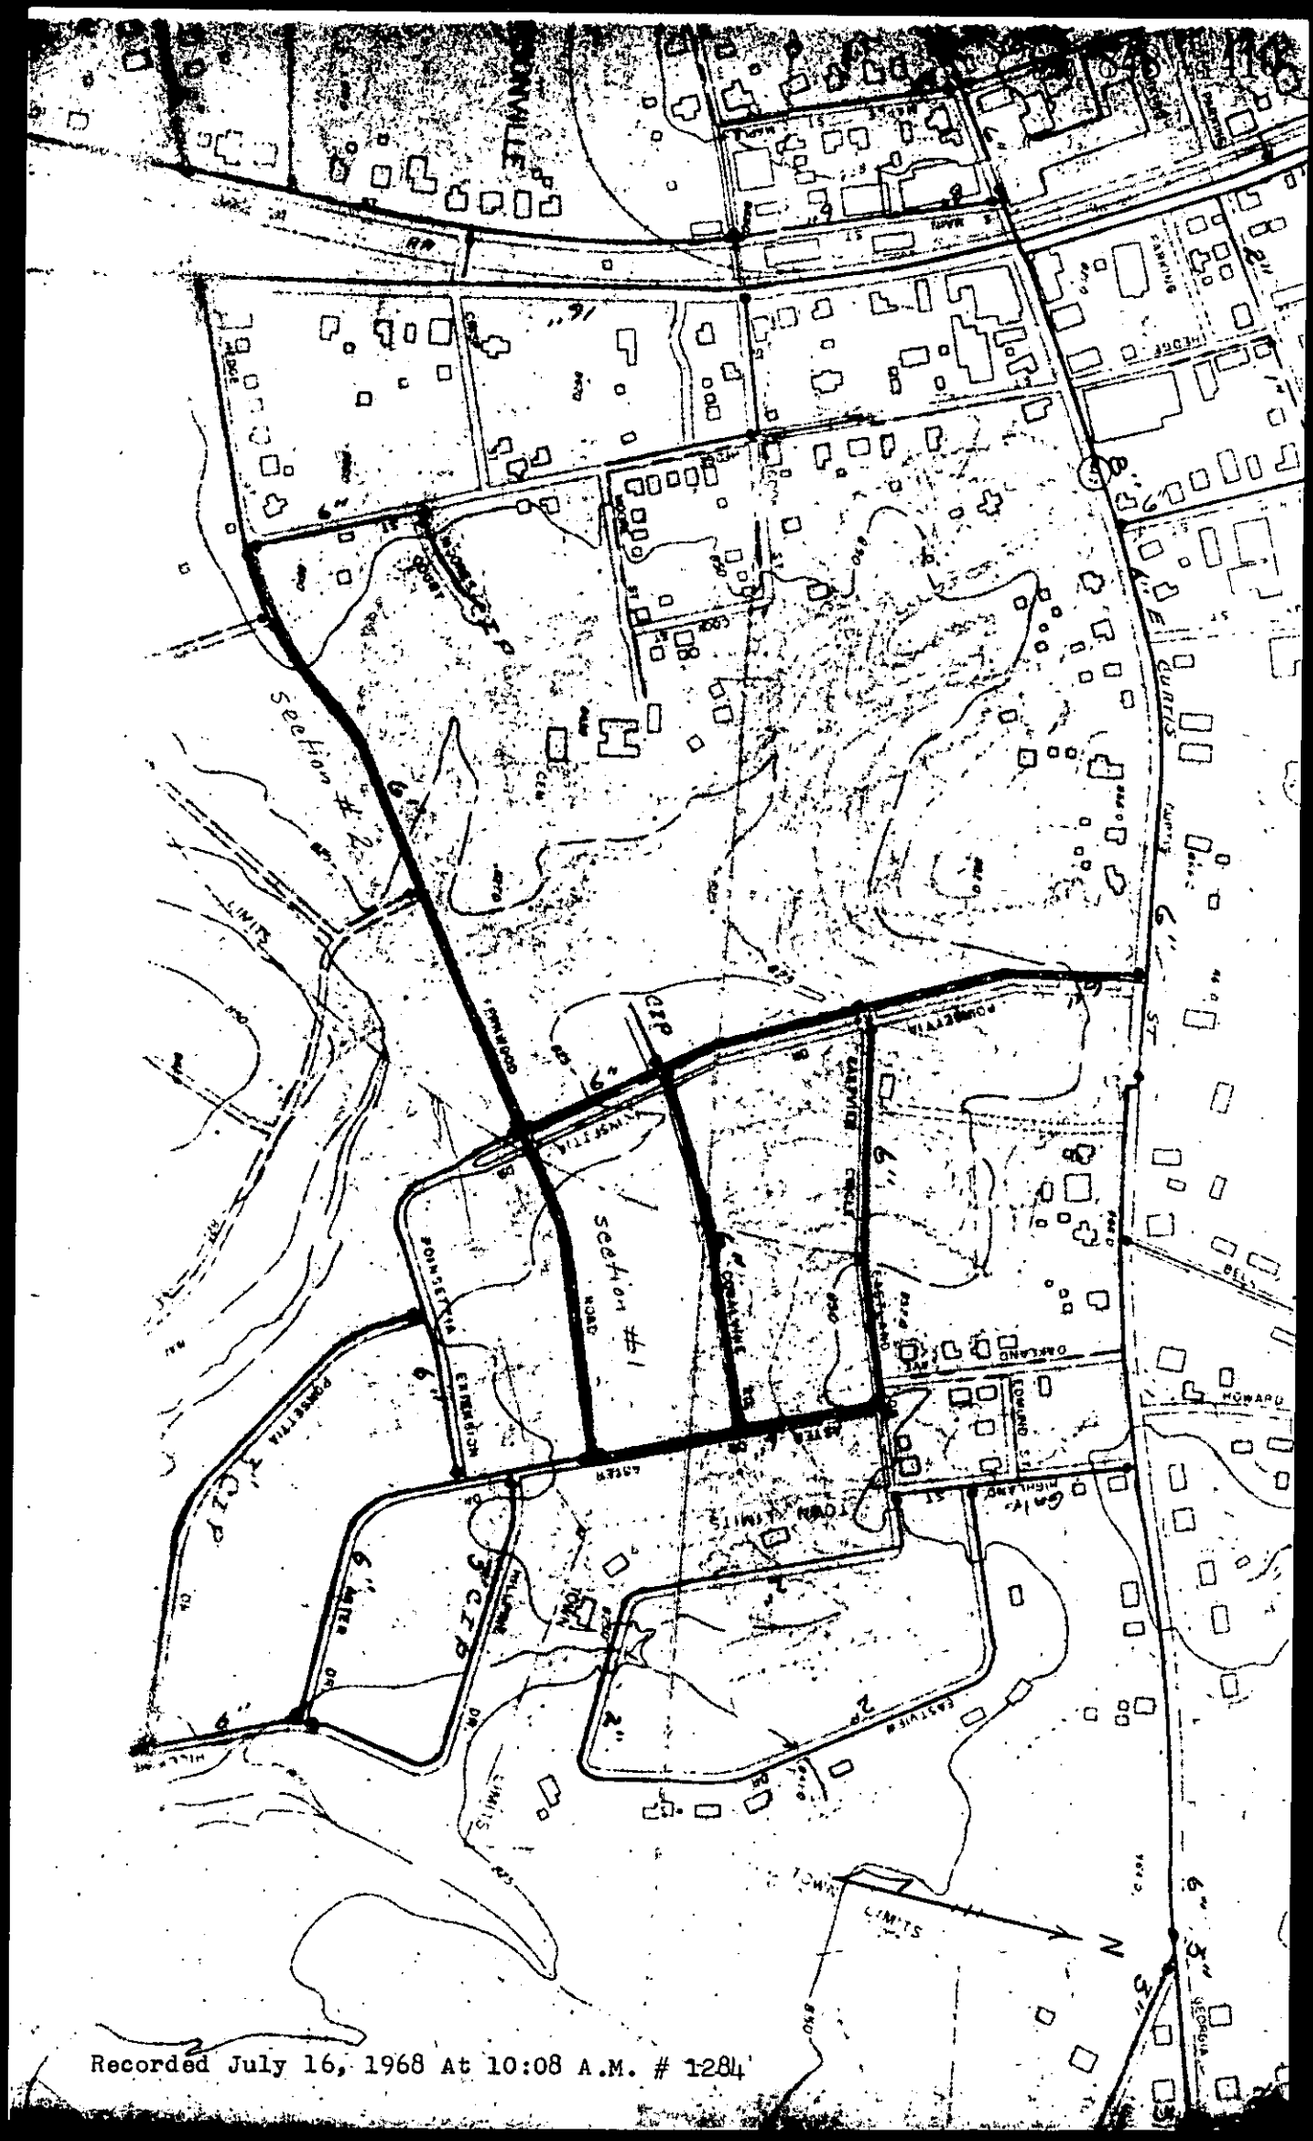

Recorded July 16, 1968 At 10:08 A.M. # 1284