


GREENVILLE

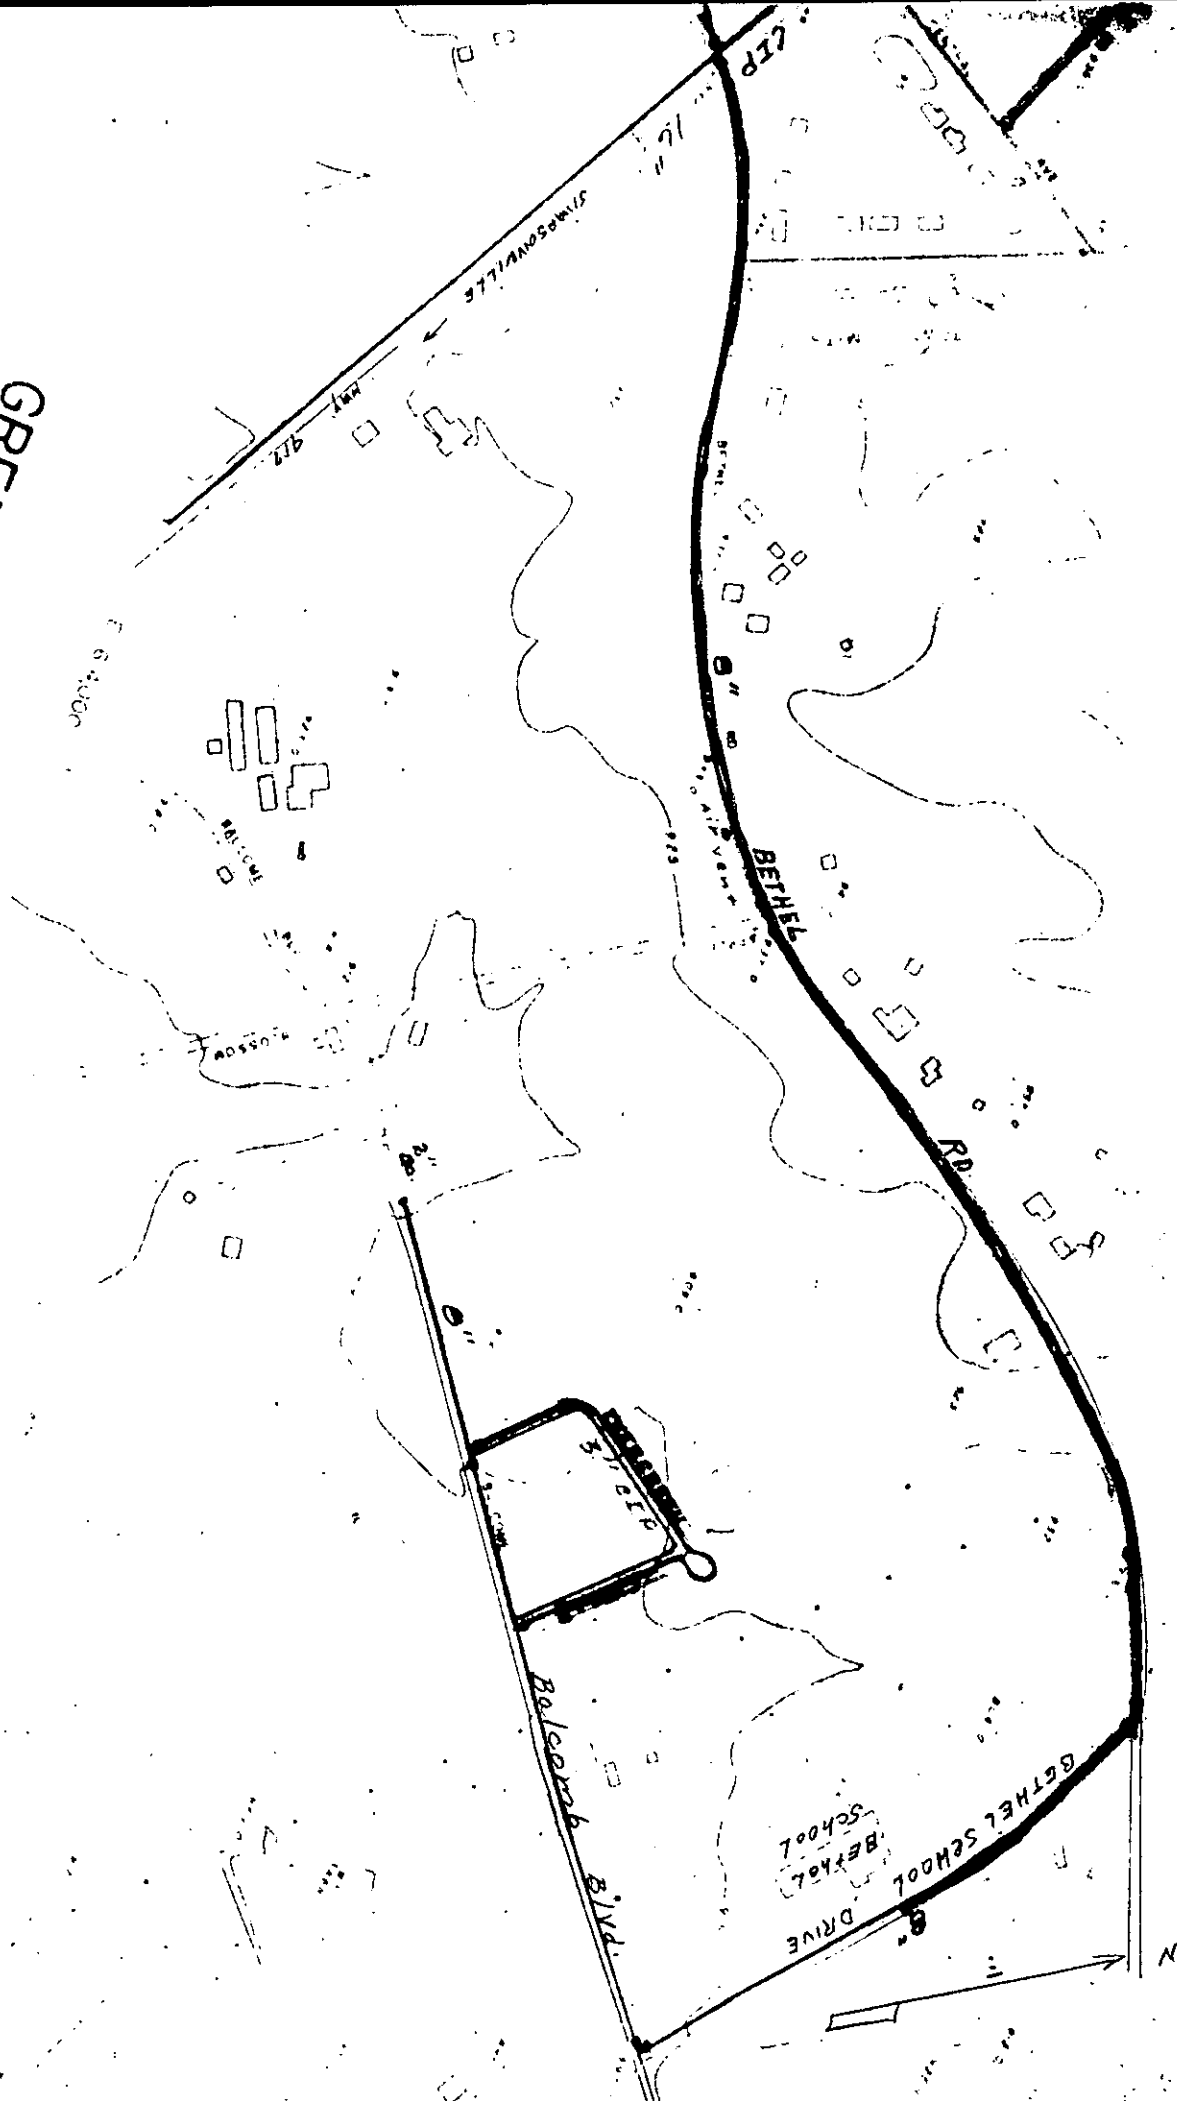

Recorded July 16, 1968 At 10:07 A.M. # 1282