


WADE HAMPTON GARDENS
SECT. 2

PLAT 1279

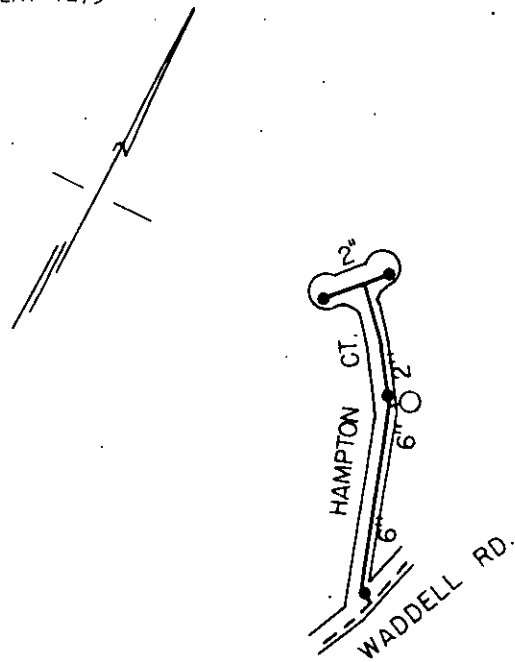

P. 1279

MATERIAL LIST

- 500' ± - 6" C.I. Pipe
- 510' ± - 2" Galv. Pipe
- 2 - 6" Valves
- 3 - 2" Valves
- 1 - Fire Hydrant

Alvin A. McCall, Jr.
To
Wade Hampton Water & Sewer District

Scale 1"=400', June 1968

Recorded December 31, 1968 At 4:56 P.M. # 15629