


NEAL CIRCLE

Plat 406

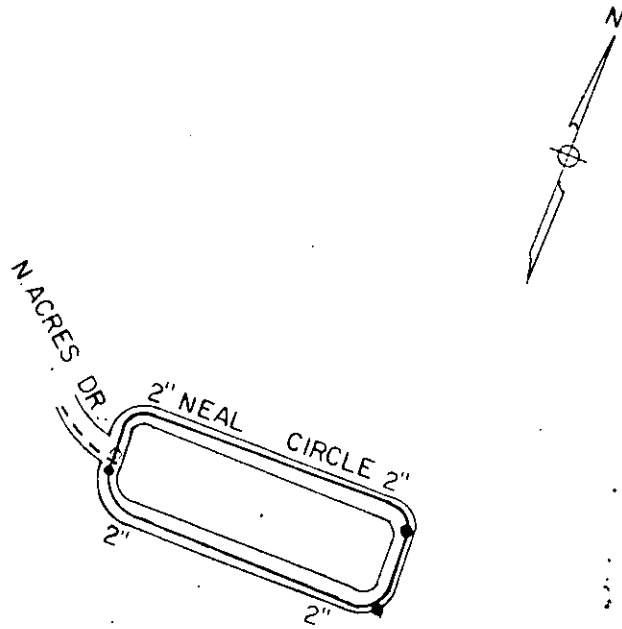

MATERIAL LIST

- 1,954' + -2" Galv. Pipe
- 3 -2" Valves

Glynn A. Lindsey
To
Wade Hampton Water & Sewer District

Scale 1" = 400', July 1968

Recorded December 31, 1968 At 4:53 P.M. # 15648