


PLAT 825

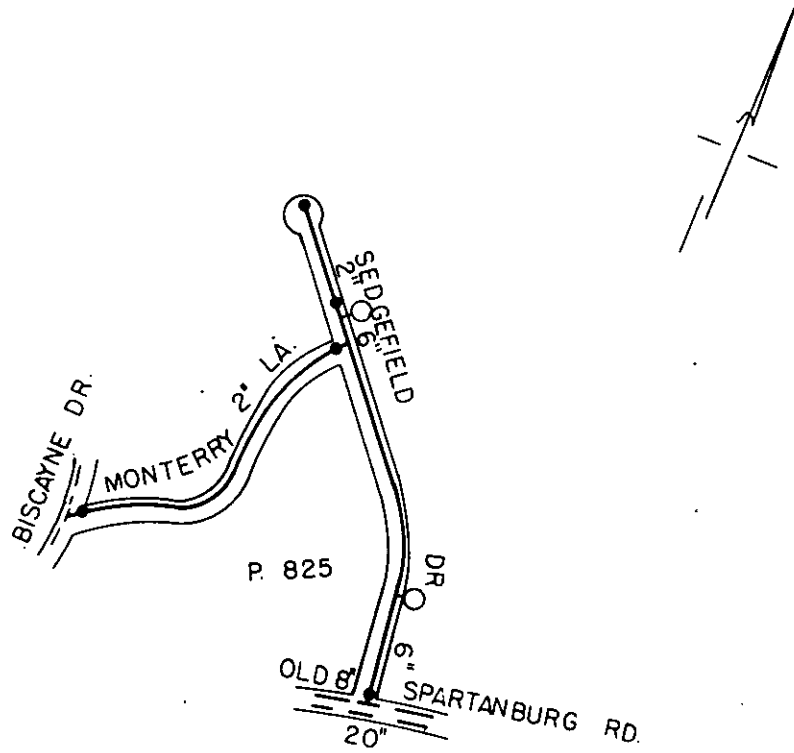

MATERIAL LIST

- 965'± - 6" C.I. Pipe
- 1,240'± - 2" Galv. Pipe
- 3 - 6" Valves
- 4 - 2" Valves
- 2 - Fire Hydrants

S.W. Creech, Trustee  
To  
Wade Hampton Water and Sewer District

Scale 1"=400', June 1968

Recorded December 31, 1968 At 4:56 P.M. # 15660