


SCALE 1"=100'

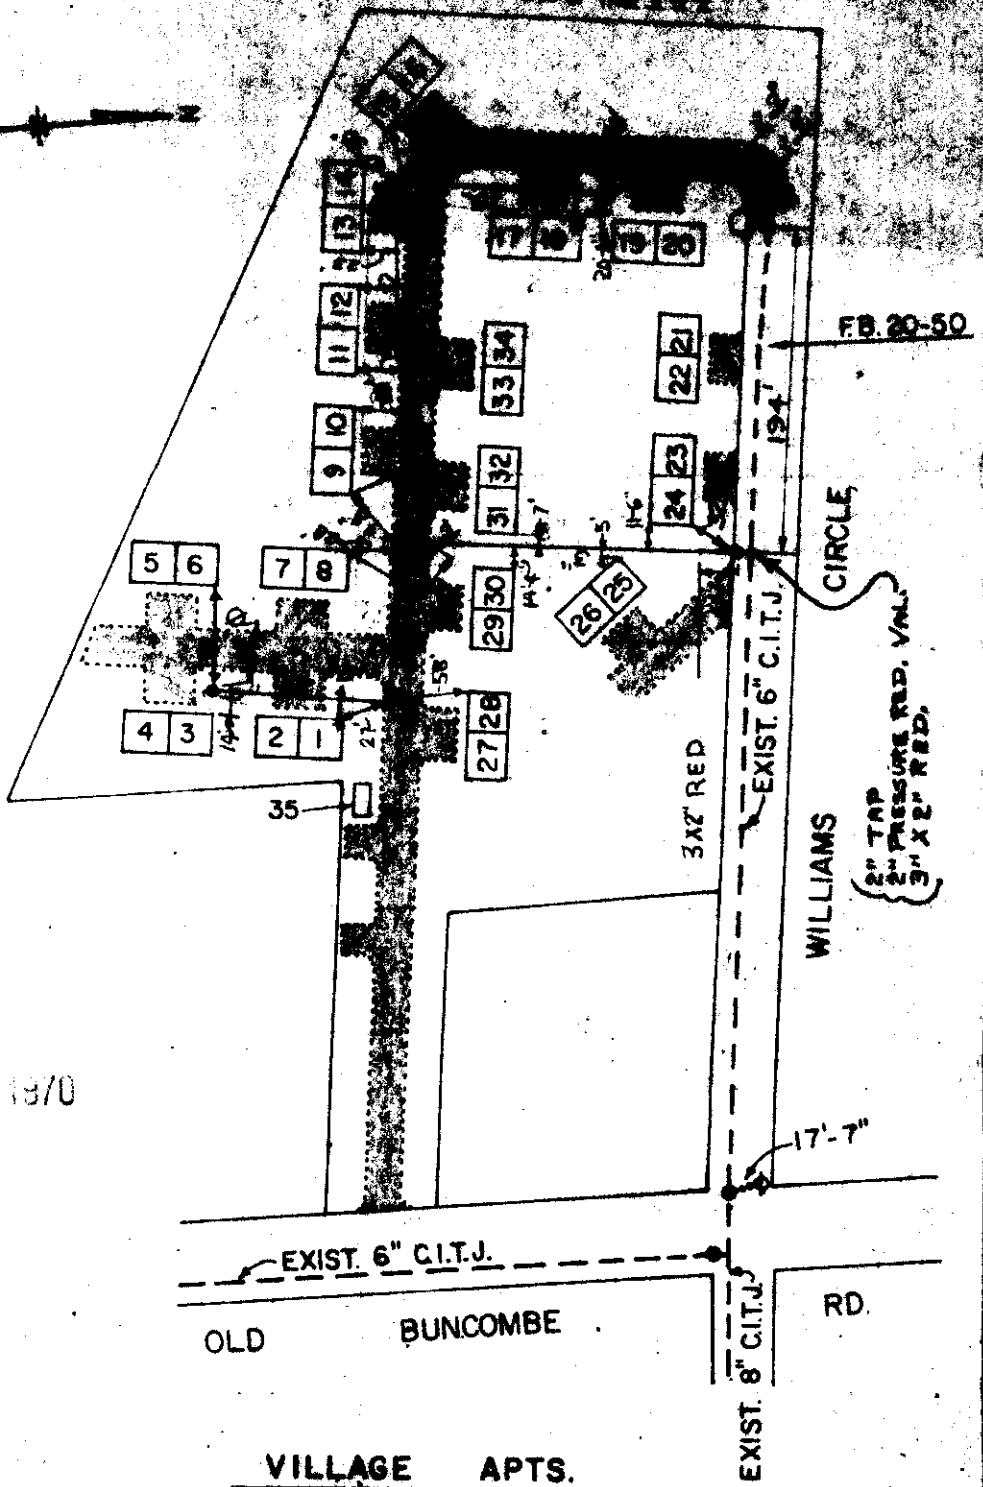

11/1970

FILED  
 GREENVILLE CO. S. C.  
 SEP 23 10 07 AM '70  
 OLLIE FARNSWORTH  
 R. H. C.

VILLAGE APTS.

APRIL, 1970

TRAVELERS REST, S.C.

Recorded September 23rd, 1970 at 10:07 A.M. #7144