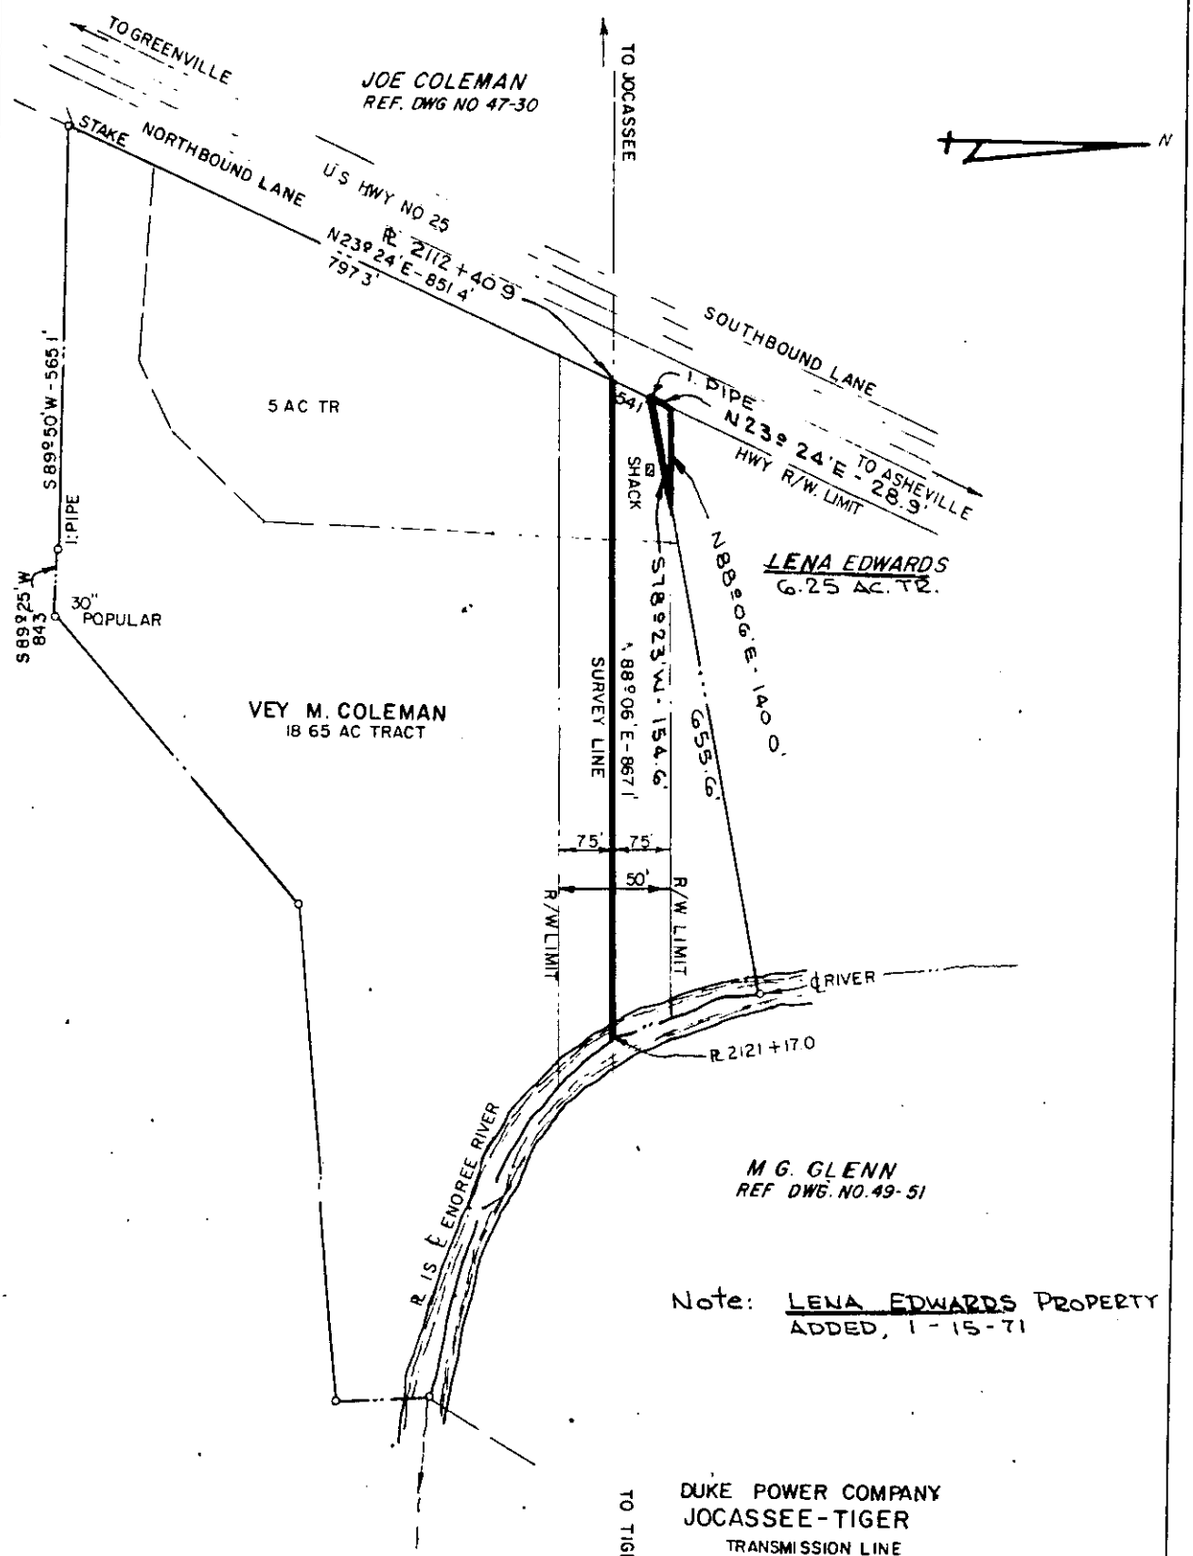

Note: LENA EDWARDS PROPERTY ADDED, 1-15-71

DUKE POWER COMPANY
JOCASSEE-TIGER
TRANSMISSION LINE
CROSSING PROPERTY OF
VEY M. COLEMAN
NEAR TRAVLERS REST, S.C.
BATES TOWNSHIP
GREENVILLE COUNTY

Plat Recorded March 17th, 1971 at 4:32 P. M. #21631

T.O. NO. 7123-150, 7123-150-A

SCALE 1"=200
BOOK NO. 1196

FEB 6, 1970
FILE NO. 49-47