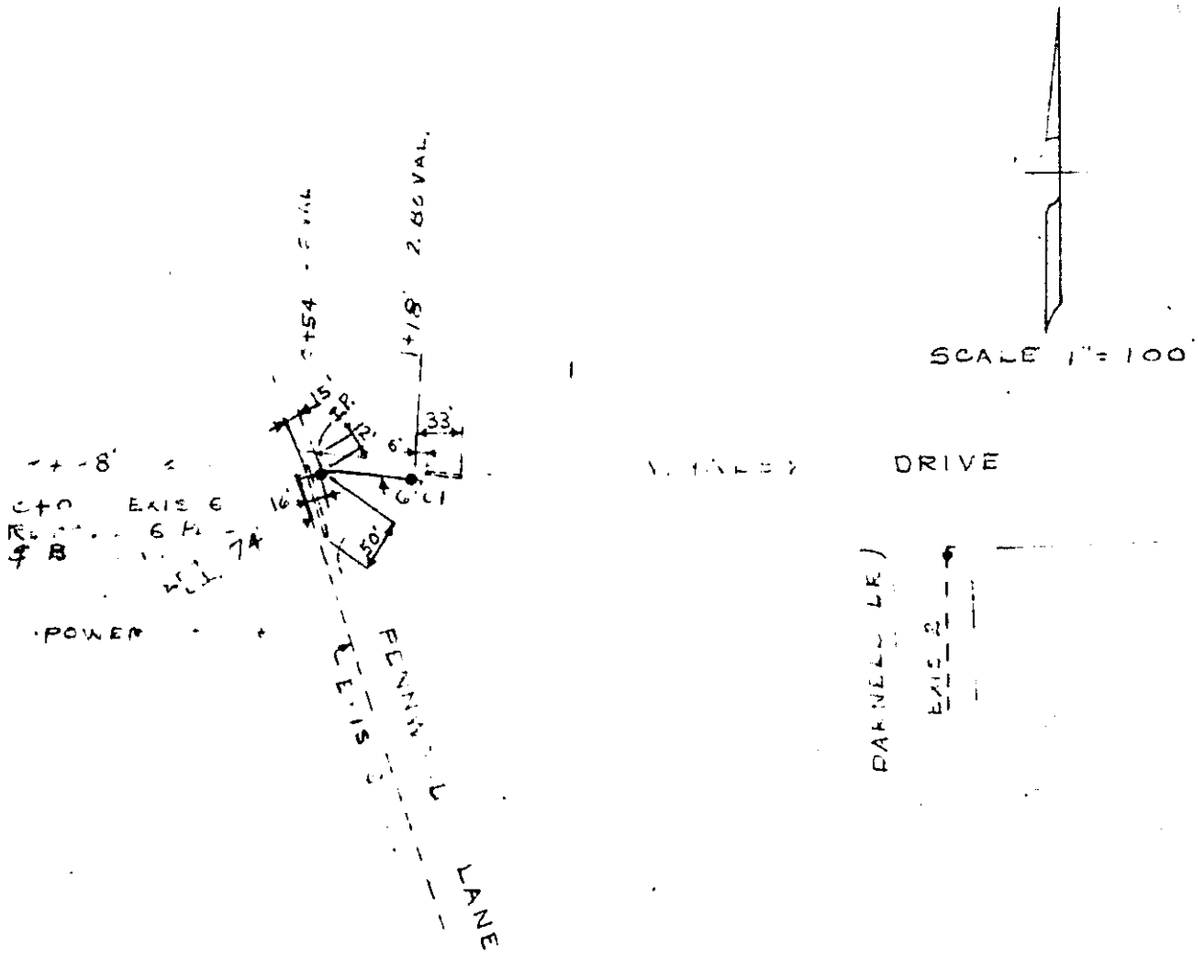

ALLEN B FRAZIER
WHALEY DRIVE
AUGUST 1970

Material List

[illegible]" Pipe	-	11[illegible]'
3" Valve	-	1

Allen B. Frazier
to
Piedmont Park Fire Dist.
Jan. 26, 1971

Plat Recorded March 22nd, 1971 at 3:40 P. M. #21954