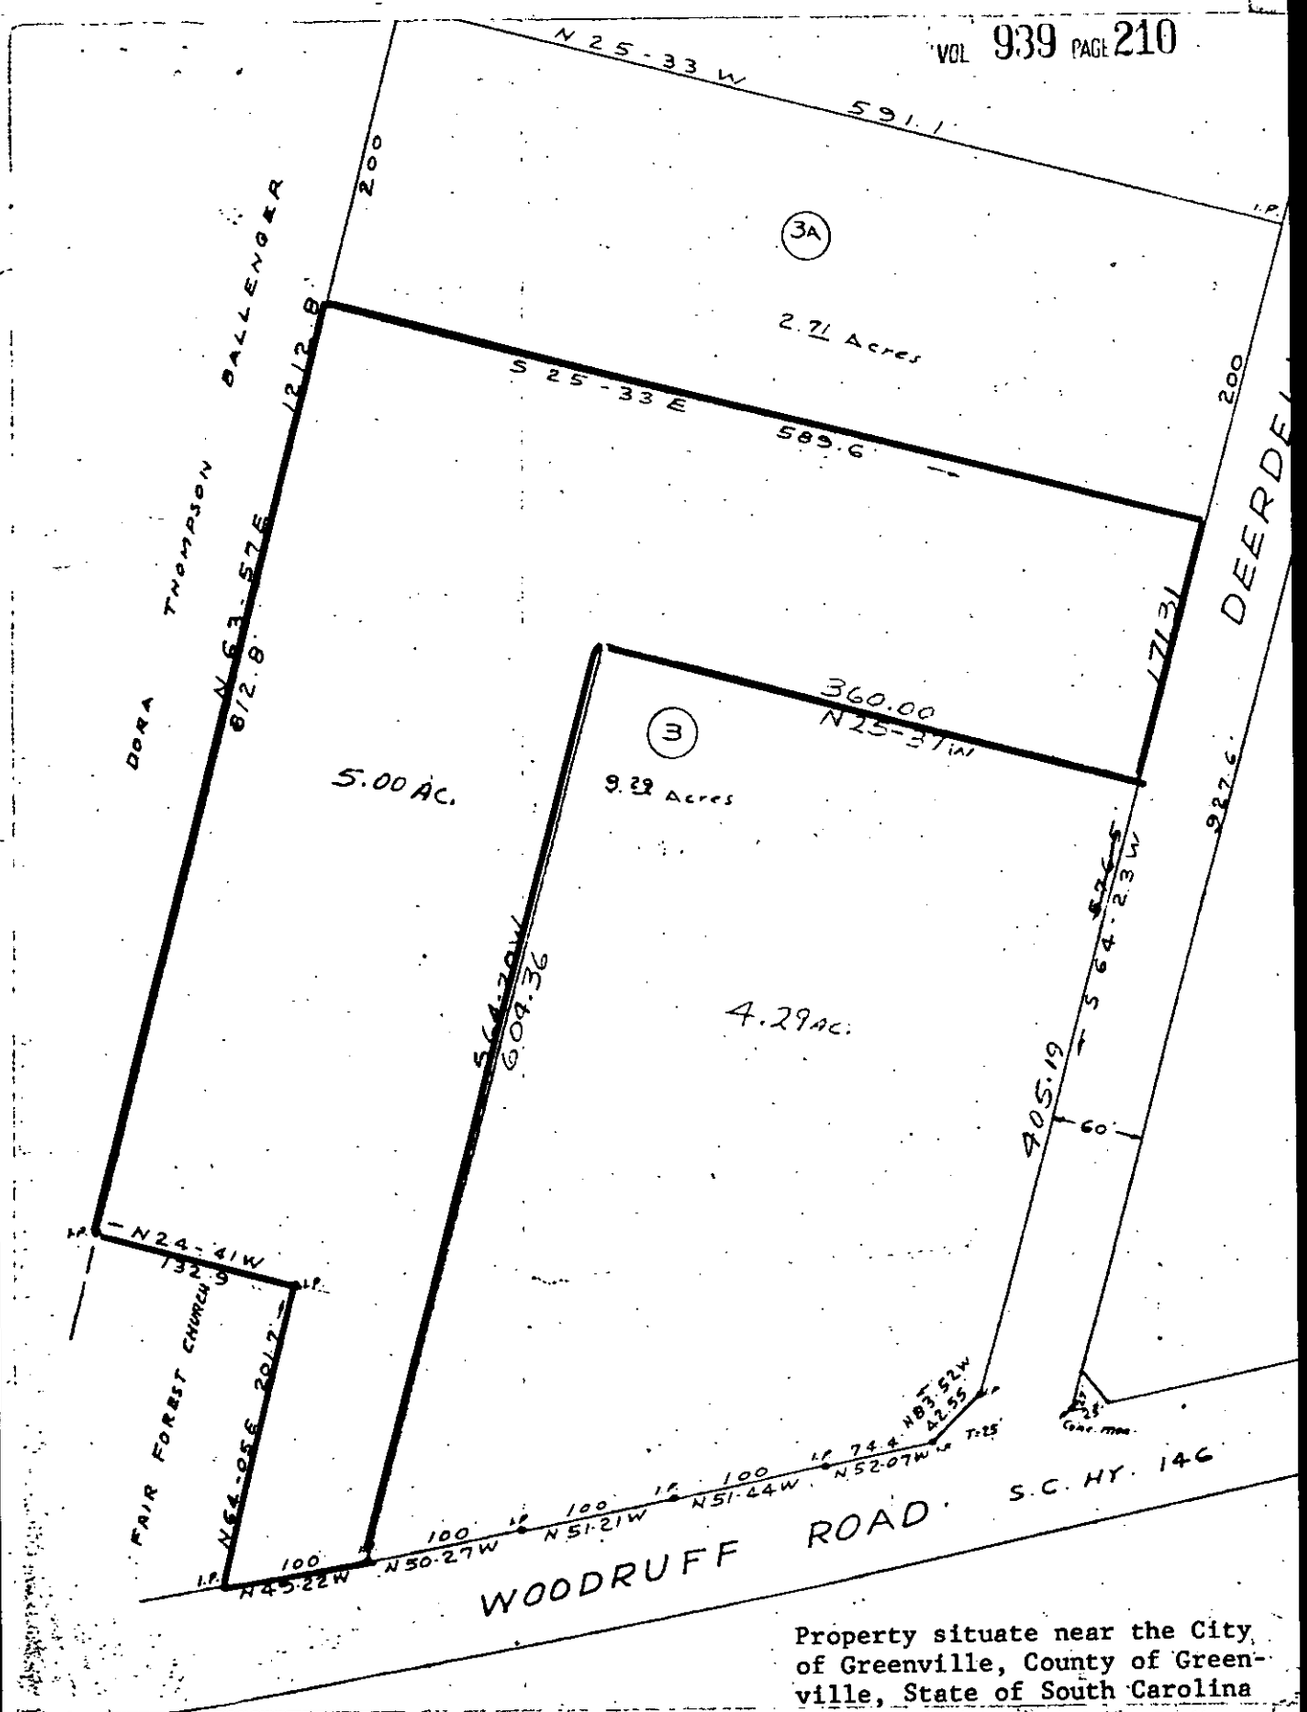

Property situate near the City of Greenville, County of Greenville, State of South Carolina

Plat & Memorandum Of Option To Purchases Real Estate Recorded March 24, 1972 at 2:54 P. M., #25603

Exhibit A