


SCALE: 1" = 400'

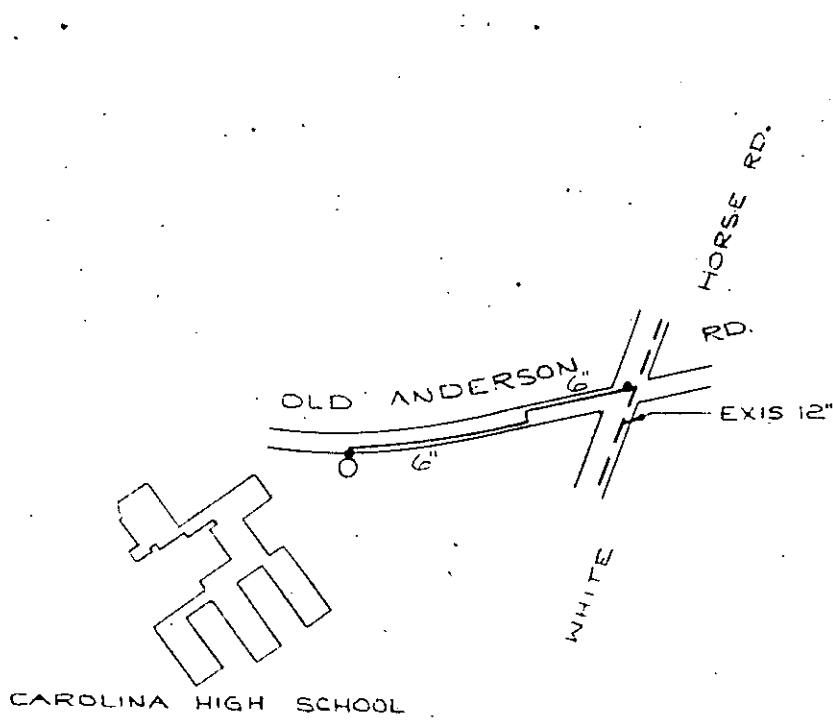

Material List:

- 688' - 8" C. I. Pipe
- 1 - Fire Hydrant
- 2 - 6" Valves

School District of Greenville County  
to  
Parker Water & Sewer Sub-District  
February 22, 1955

Plat and Bill Of Sale Recorded July 26, 1972 at 2:56 P. M., #2504