


LIMITS

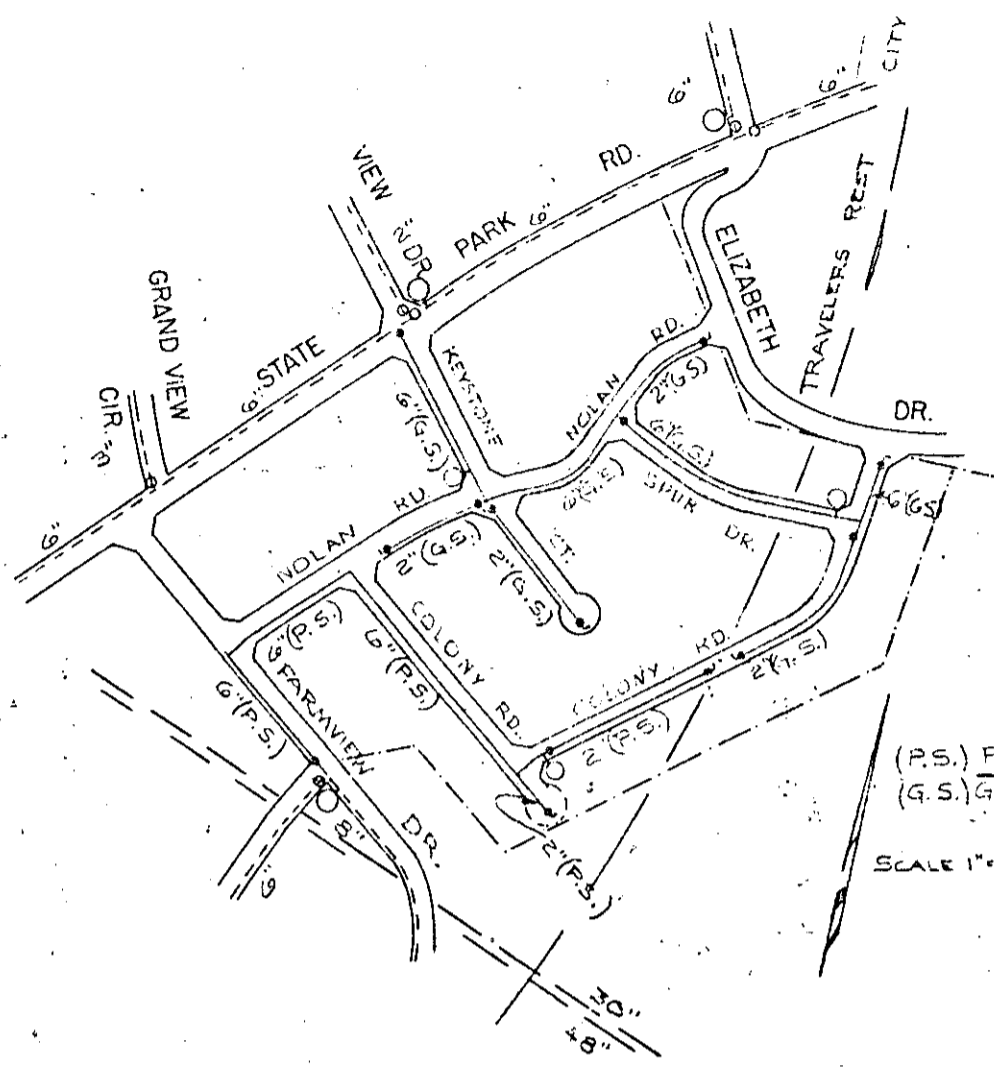

(P.S.) PUMP SYSTEM
(G.S.) GRAVITY SYSTEM

SCALE 1" = 400'

POINTS NORTH

Material List:

6" Pipe	-	3168'
2" Pipe	-	2049'
6" Valves	-	6
2" Valves	-	11
Fire Hydrants	-	3

BLK. B. No. 492-1-14 & 14.1
 Points North Development Co.,
 A Partnership
 to
 Commissioners of Public Works
 Of The City of Greenville, S. C.
 May 16, 1973

Plat Recorded June 19, 1973 at 11:51 A. M., # 36606