


0560

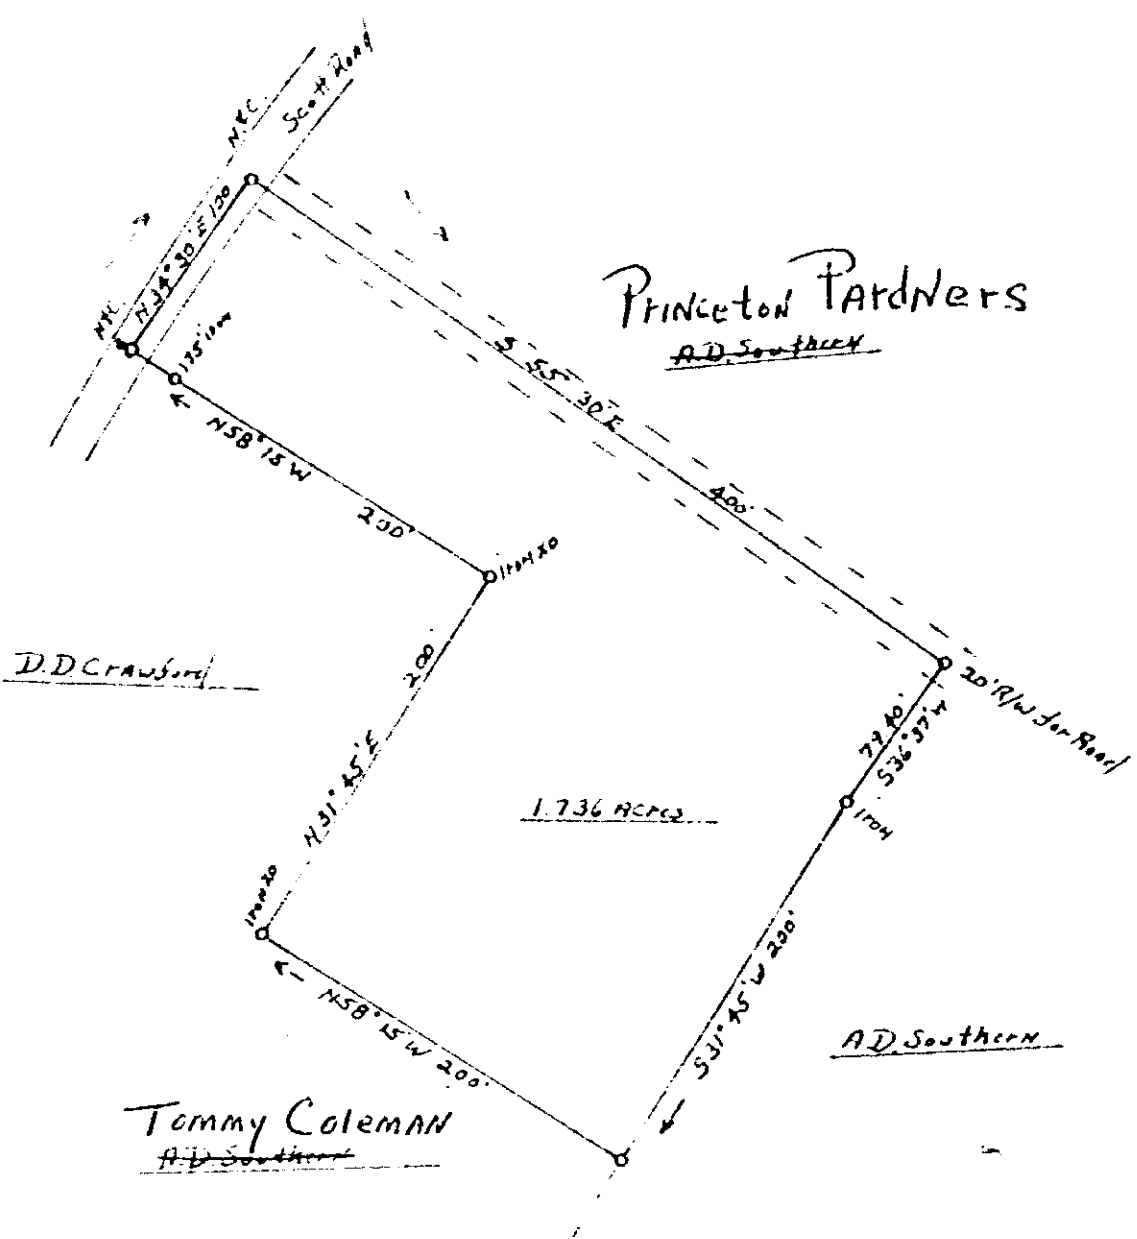

South Carolina  
Greenville County

Plat Showing  
 Lot of Land for  
 D.D. Crawford  
 1.736 ACRES  
 Scale: 1" = 100' October 11, 1969  
 Wm. J. Martin  
 S.C. Reg. L.S. # 2320

RECORDED JAN 22 '74 18422

4328 RV-2