


8170

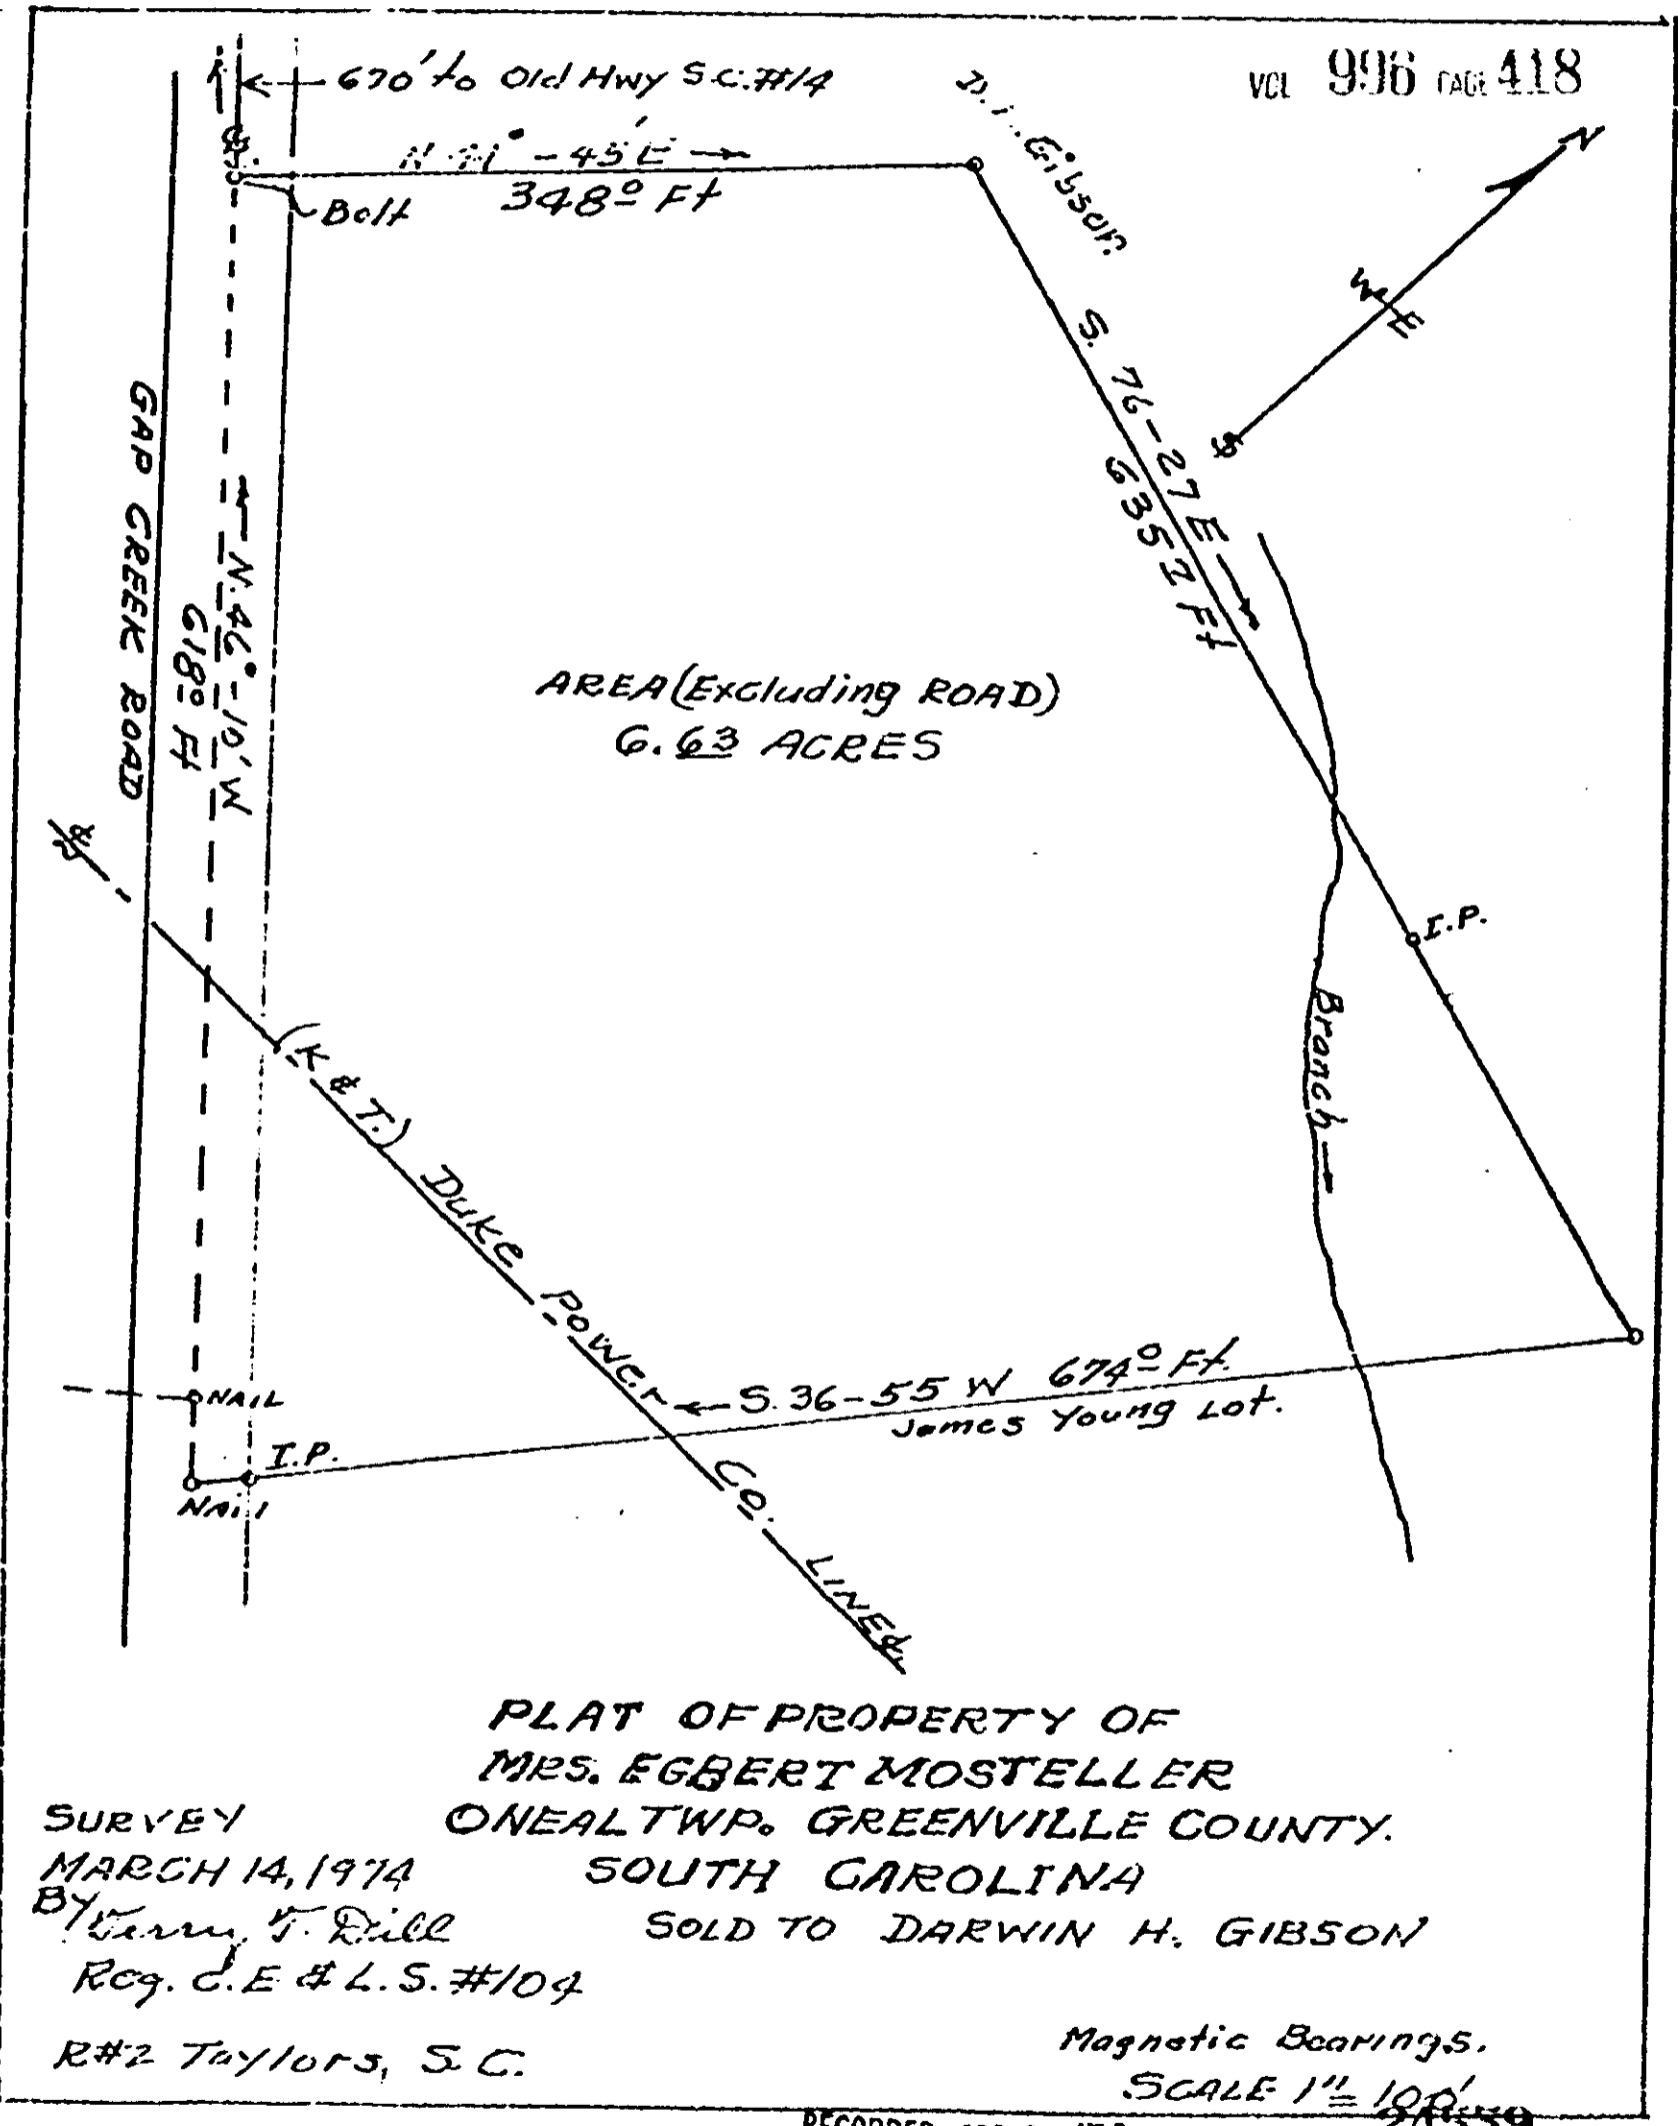

VCL 996 PAGE 418

Deed and Plat

RECORDED APR 2 '74

29559

4328 RV.2