










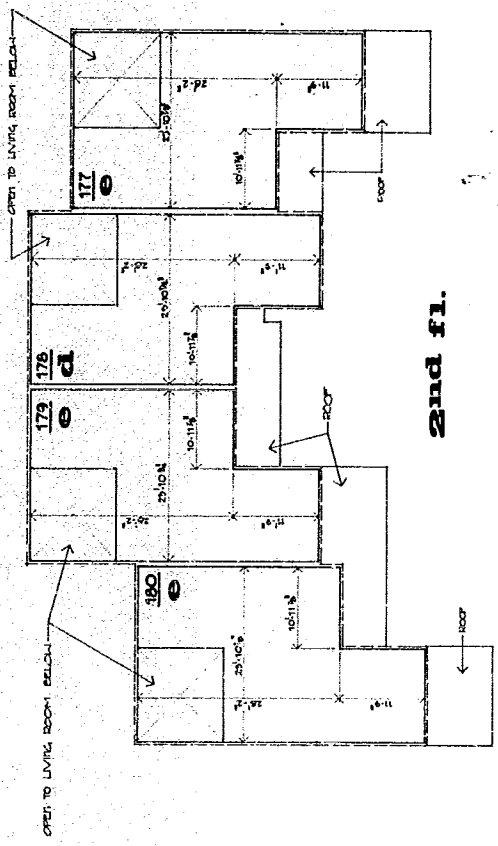

2nd fl.

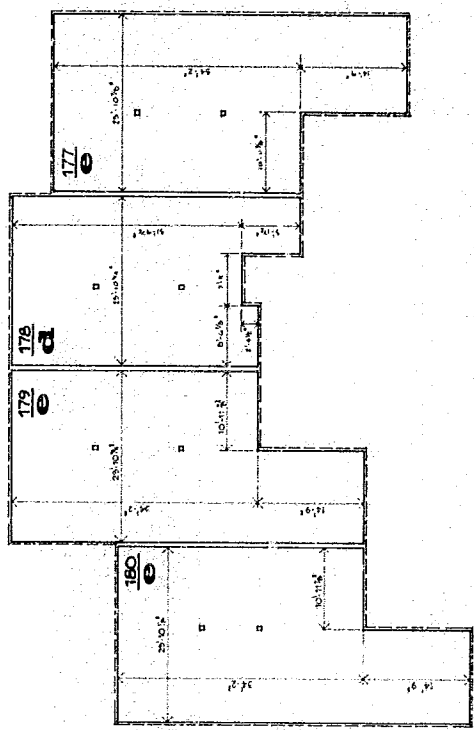

bldg. O 1st fl.

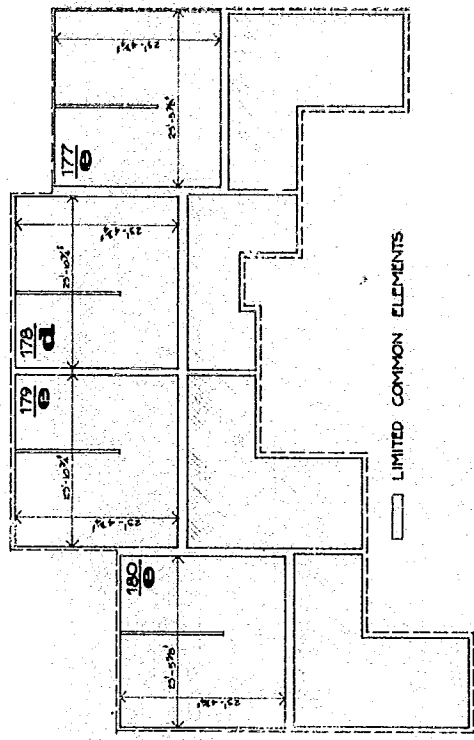

bldg. O found/basement

INGLEWOOD HORIZONTAL PROPERTY REGIME

I, James H. Miller, certify that the within floor plans are true and correct to the best of my knowledge.  
 [Signature]  
 James H. Miller  
 South Carolina Registration No. 1243

