

W x H: B4 B








VOL 1008 PAGE 127

1008  
127

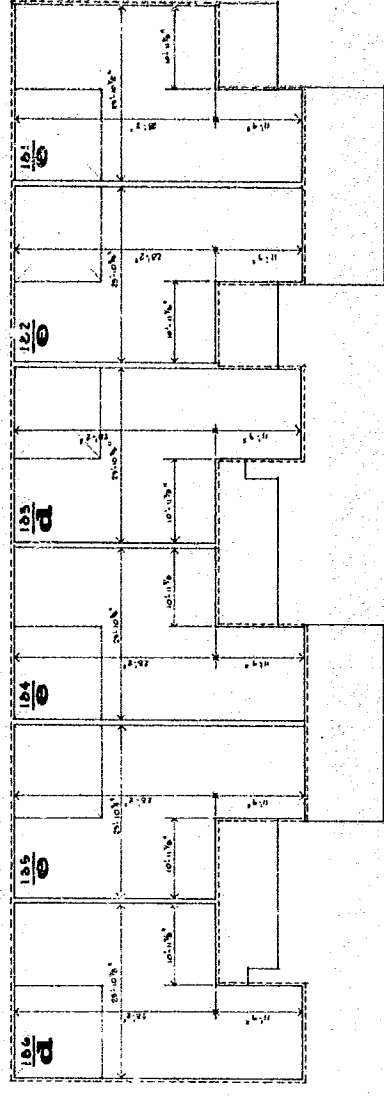

2nd fl.

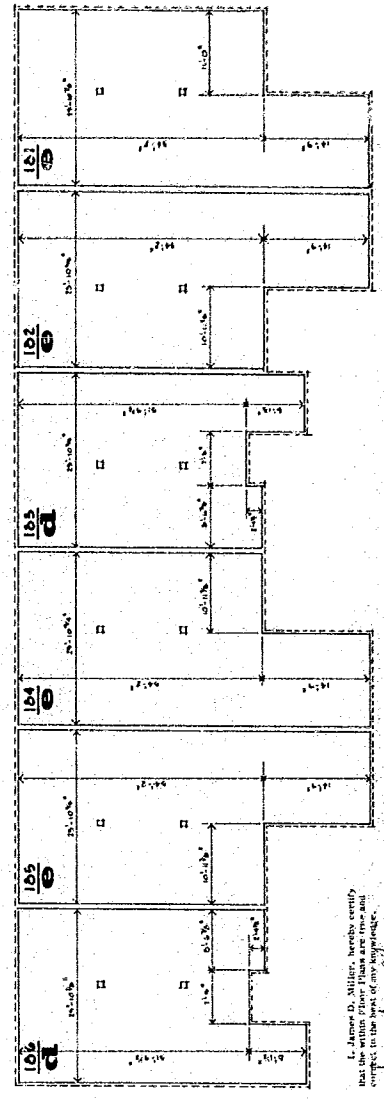

bldg. P 1st fl. INCLWOOD HORIZONTAL PROPERTY REGIME




