0570

4328 RV.2

BOOK 1008 PAGE 570

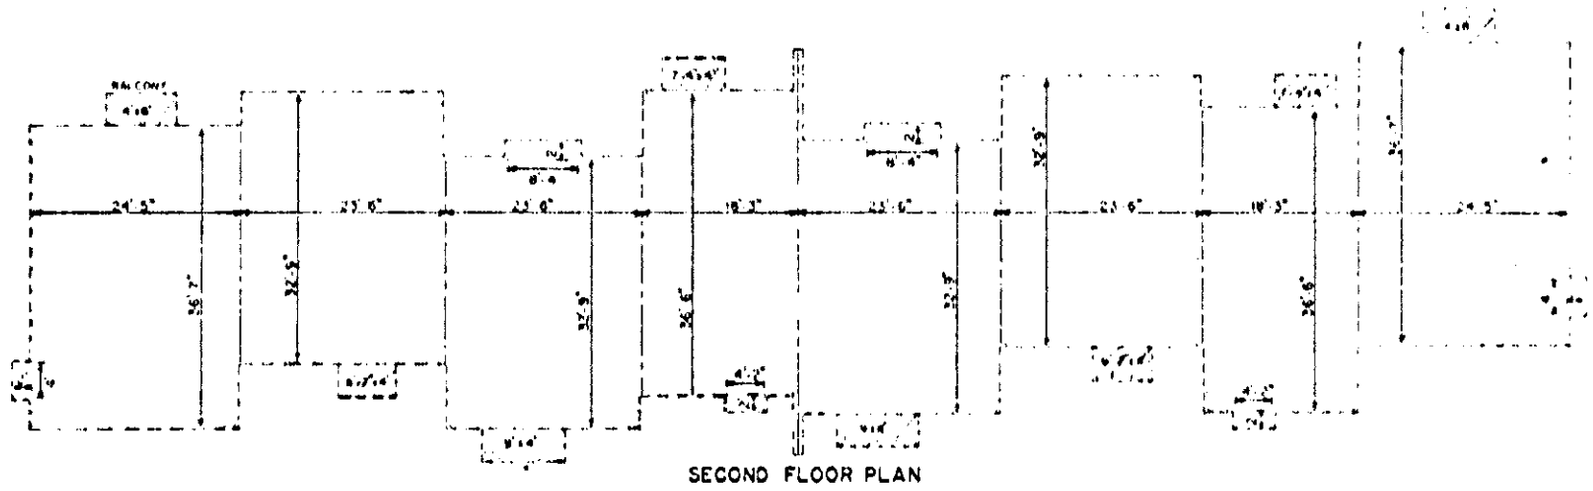

SECOND FLOOR PLAN

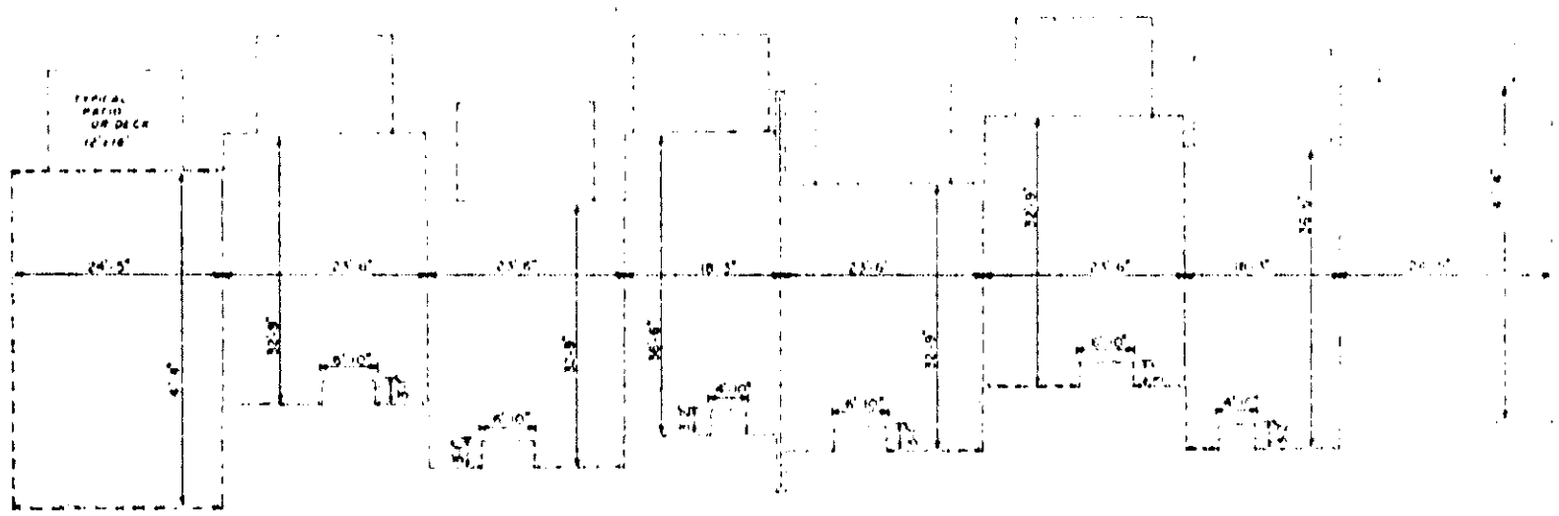

FIRST FLOOR PLAN

(106) (104) (102) (100) (98) (96) (94) (92)

CERTIFICATE

I HEREBY CERTIFY THAT THE FLOOR PLANS SHOWN ON THIS DRAWING SHOW THE DIMENSIONS, AREA, AND LOCATION OF EACH APARTMENT AND COMMON ELEMENTS AS ARE MORE FULLY SHOWN ON THE FLOOR PLANS OF TRENTWOOD HORIZONTAL PROPERTY REGIME PREPARED BY ENWARD ASSOCIATES, GREENVILLE, S.C. DATED [illegible]

John W. Kibler
2734 N. DECATUR RD.
DECATUR, GEORGIA

REGISTRATION NUMBER 4037

AREA PER RESIDENCE (square feet)

NO.	FIRST FLOOR	SECOND FLOOR	[illegible]
92	[illegible]	[illegible]	[illegible]
94	[illegible]	[illegible]	[illegible]
96	74856	[illegible]	[illegible]
98	74856	[illegible]	[illegible]
100	[illegible]	[illegible]	[illegible]
102	74856	[illegible]	[illegible]
104	74856	[illegible]	[illegible]
106	100923	[illegible]	[illegible]

NOTES

1. [illegible] in the Master Deed.
2. Floor plan dimensions are [illegible] registration number [illegible].
3. All interior and exterior [illegible]

TRENTWOOD

HORIZONTAL PROPERTY REGIME

FLOOR PLANS

LEGEND

- COMMON ELEMENT
- BOUNDARY BETWEEN ADJACENT RESIDENCES
- BOUNDARY OF RESIDENCE
- LIMITED COMMON ELEMENT

1 INCH = 20 FEET

20 10 0 20 40 60 80 100

SHEET NO. 8