


0860

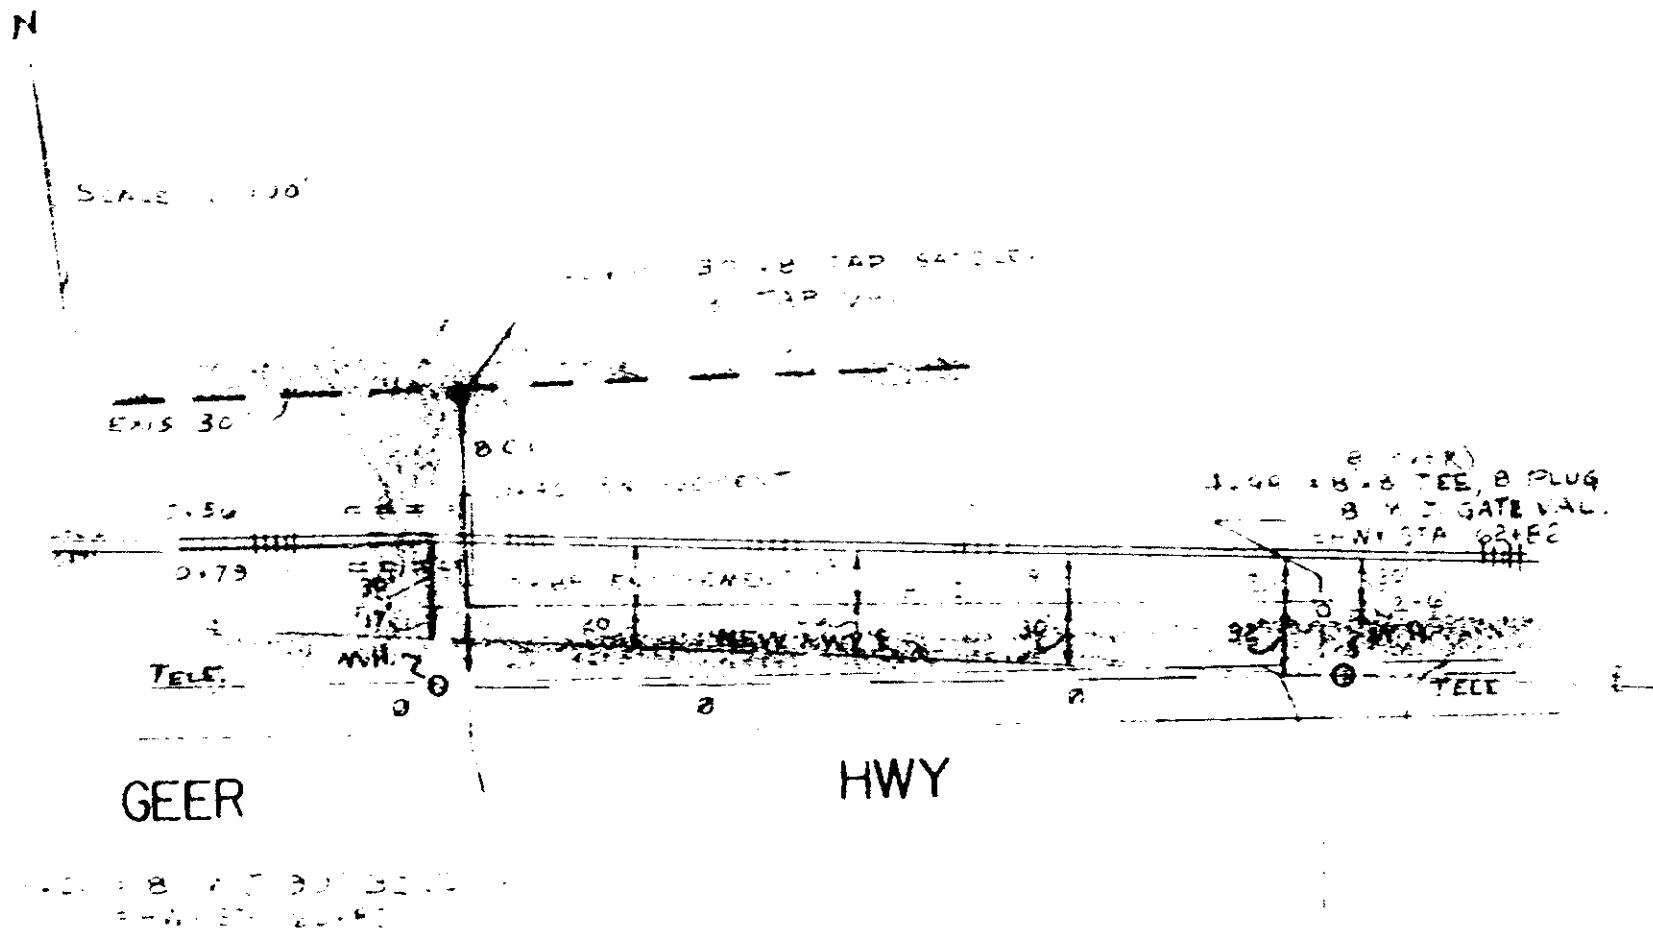

NORTH GREENVILLE HOSP.
 OCTOBER, 1974 BLK BK. 506.6-1-14

Material List:

RECORDED DEC 17 '74 14838

4328 RV-2