


9847

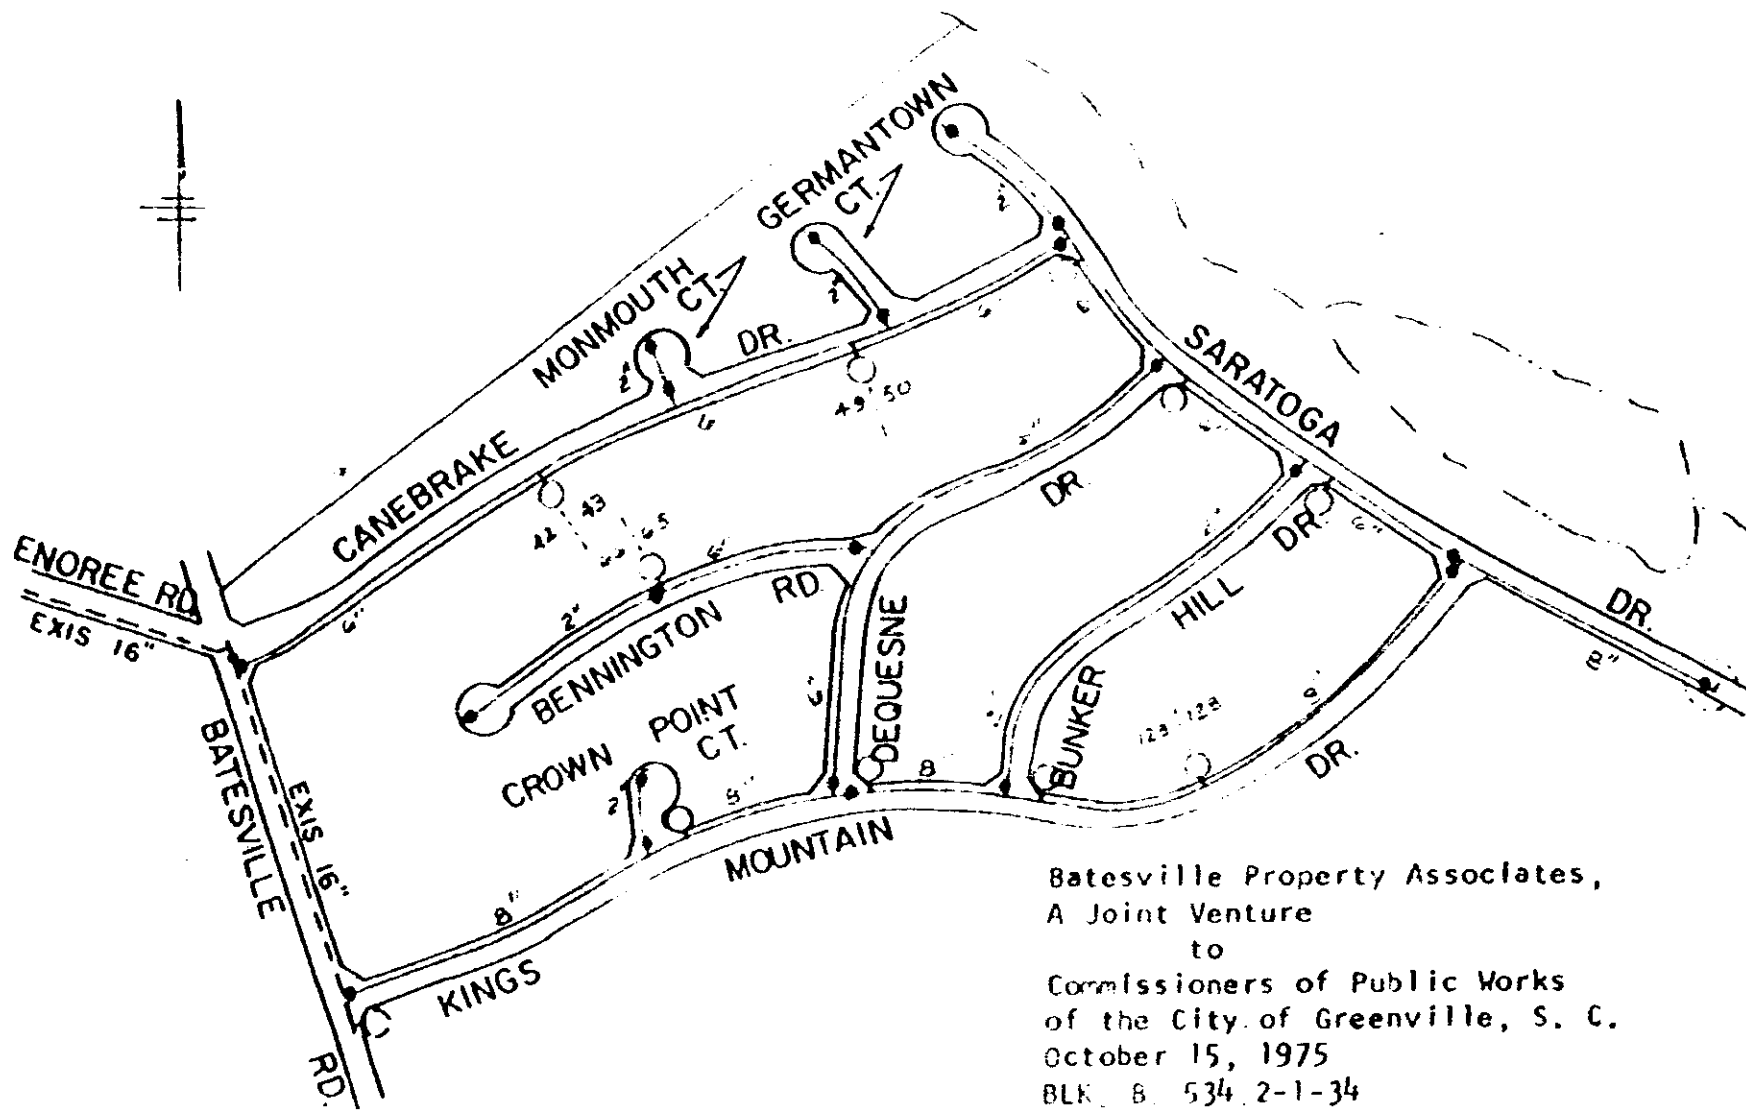

Batesville Property Associates,
A Joint Venture
to
Commissioners of Public Works
of the City of Greenville, S. C.
October 15, 1975
BLK. B 534 2-1-34

CANEBRAKE SEC. I
SCALE 1" = 400

NOTE: ALL 6" & 8" VALVES OPEN RIGHT
ALL FIRE HYDRANTS TO BE 3-WAY & OPEN RIGHT
ALL 2" VALVES OPEN LEFT

REVISED 9-7-75 / By DALE

Material List:

8" C. I. Pipe	-	2,830'±
6" C. I. Pipe	-	4,310'±
2" Galv. Pipe	-	2,210'±
8" Valves	-	3
6" Valves	-	16
2" Valves	-	13
Fire Hydrants	-	10

RECORDED NOV 5 '75

at 2:21 P.M.

12073

4328 RV-2