


Name and
Post Office Address
Cecil D. BISHANAN
215 Reeves St.
GREENVILLE, S.C.

Title
Line
or
Exchange Line
tributary to
GREENVILLE
Exchange

The Property is bounded where the line enters and leaves this property by the property of
REEVES STREET NORTH
LOT #3 (CHURCH HILL SHOPPING CTR) EAST
Authority 543-2073
GREENVILLE, SOUTH CAROLINA

Approved
Title District Engineer

NOV 10 1975

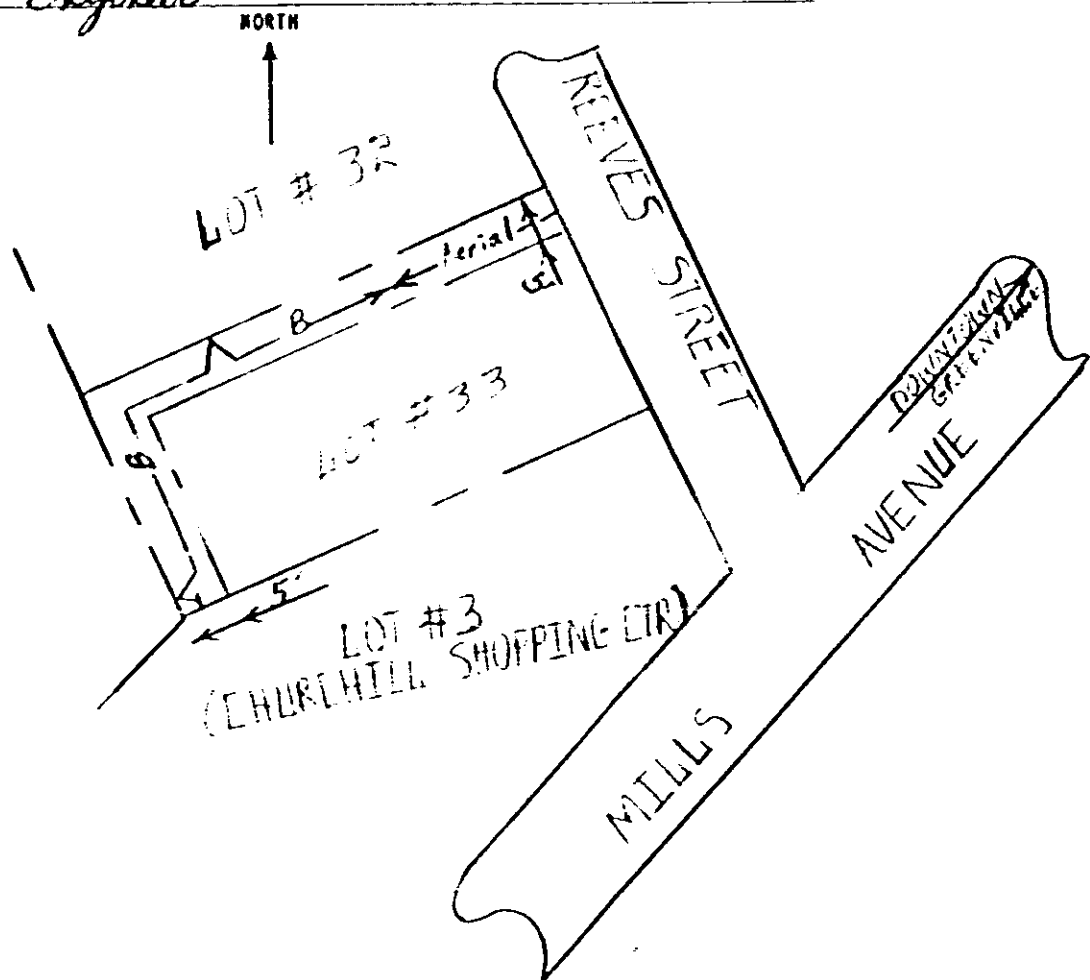

RECORDED NOV 10 '75 At 4:45 P.M.

12493

R. M. C. for G. Co. S. C.

Filed for record in the office of
the R. M. C. for Greenville
County, S. C. at 4:45 o'clock
P.M. Nov. 10, 1975
and recorded in Deed Book
1027 at page 69

12493
KA

4328 RV-2