

1027-976

MR. JACK COCHRAN
2129 GROVE ROAD
GREENVILLE, S.C.

GREENVILLE

LERoy CANNON

WEST

W. V. BATSON


EAST

543

945C

GREENVILLE

DISTRICT ENGINEER

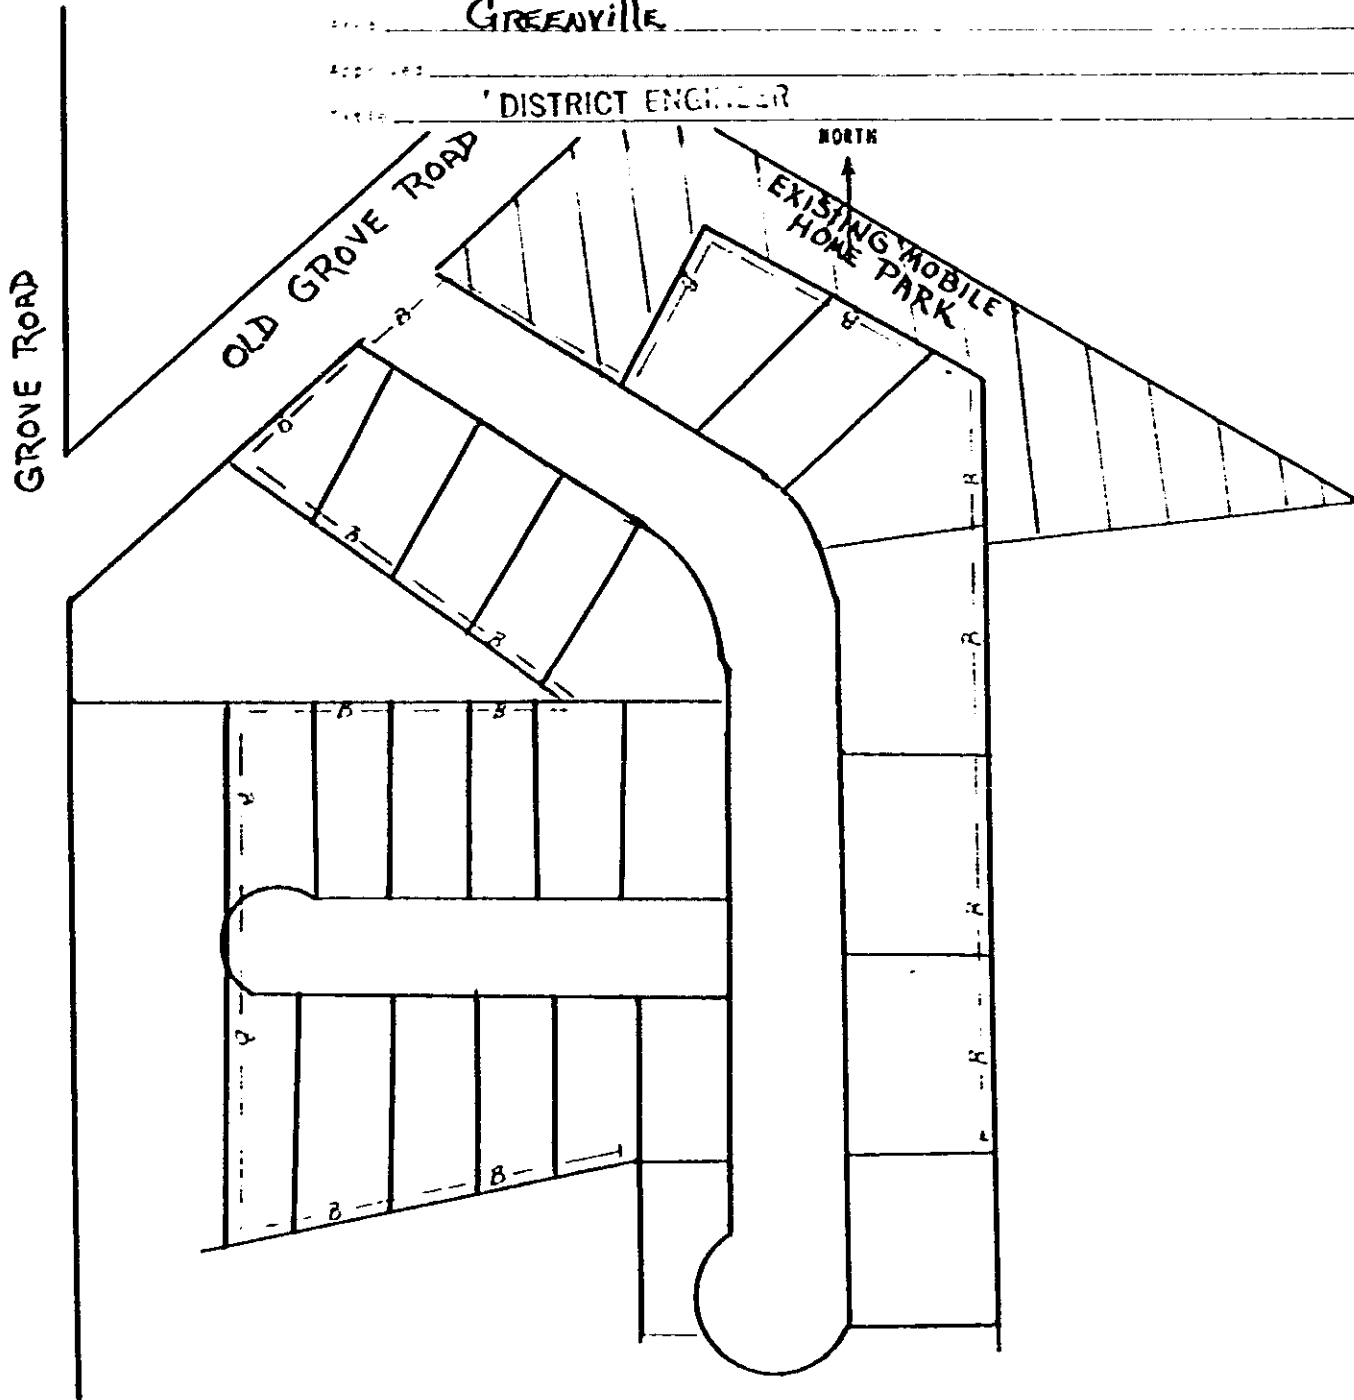

RECORDED DEC 2 '75 AT 3:33 P.M.

14368

R. M. C. for G. Co. S. C.

1027

976

Filed for recording in
the Public Records Office
of the County of Greenville,
S. C. on Dec. 2, 1975
and recorded in Book 1027
Page 976

DEC 2 1975

14368

8237

2260