

Name and Post Office Address of Grantor: **BOB JONES UNIVERSITY**
GREENVILLE, SOUTH CAROLINA
29614

Toll Line or Exchange Line: **Greenville, S. C.**


The Property is bounded where the line enters and leaves this property by the property of:
Karen Drive on the **West**
 and **White Oak Drive** on the **East**

Authority: **P-43441** Classification: **R45C**

Area: **Greenville, S. C.**

Approved: _____

Title: _____

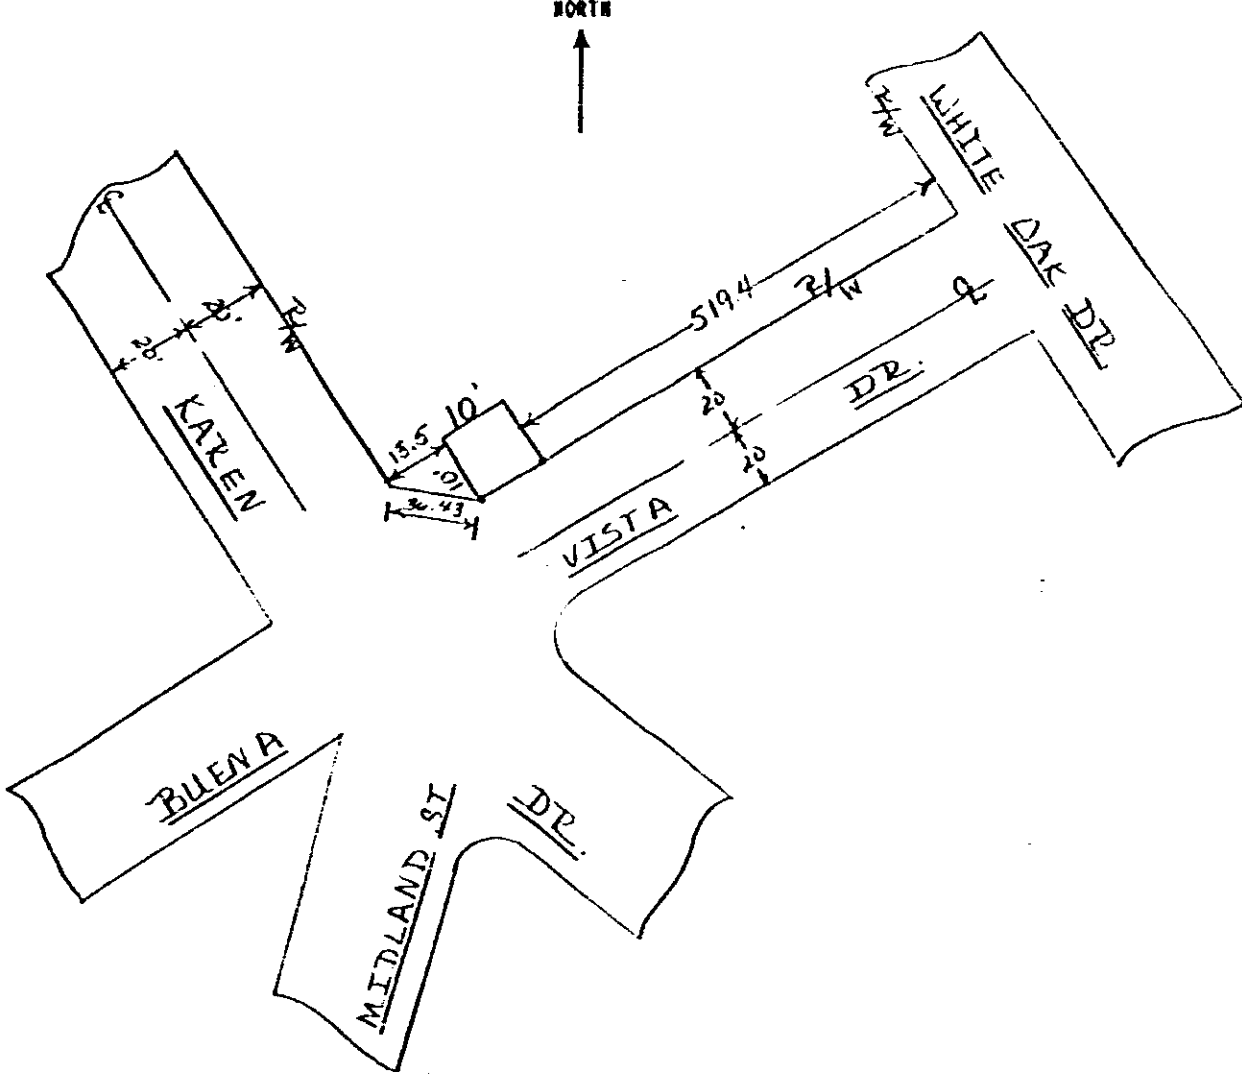

RECORDED **MAY 31 1979**
 at 2:25 P.M.

35335

Filed for record in the office of
 the R. M. C. for Greenville
 county, S. C. at 2:25 o'clock
 P. M. May 31, 1979
 and recorded in Deed Book
 1103 at page 713

R. M. C. for G. Co. S. C.

X 35335

4328 RV.2

5120