


EXHIBIT C

VOL 1108 PAGE 841

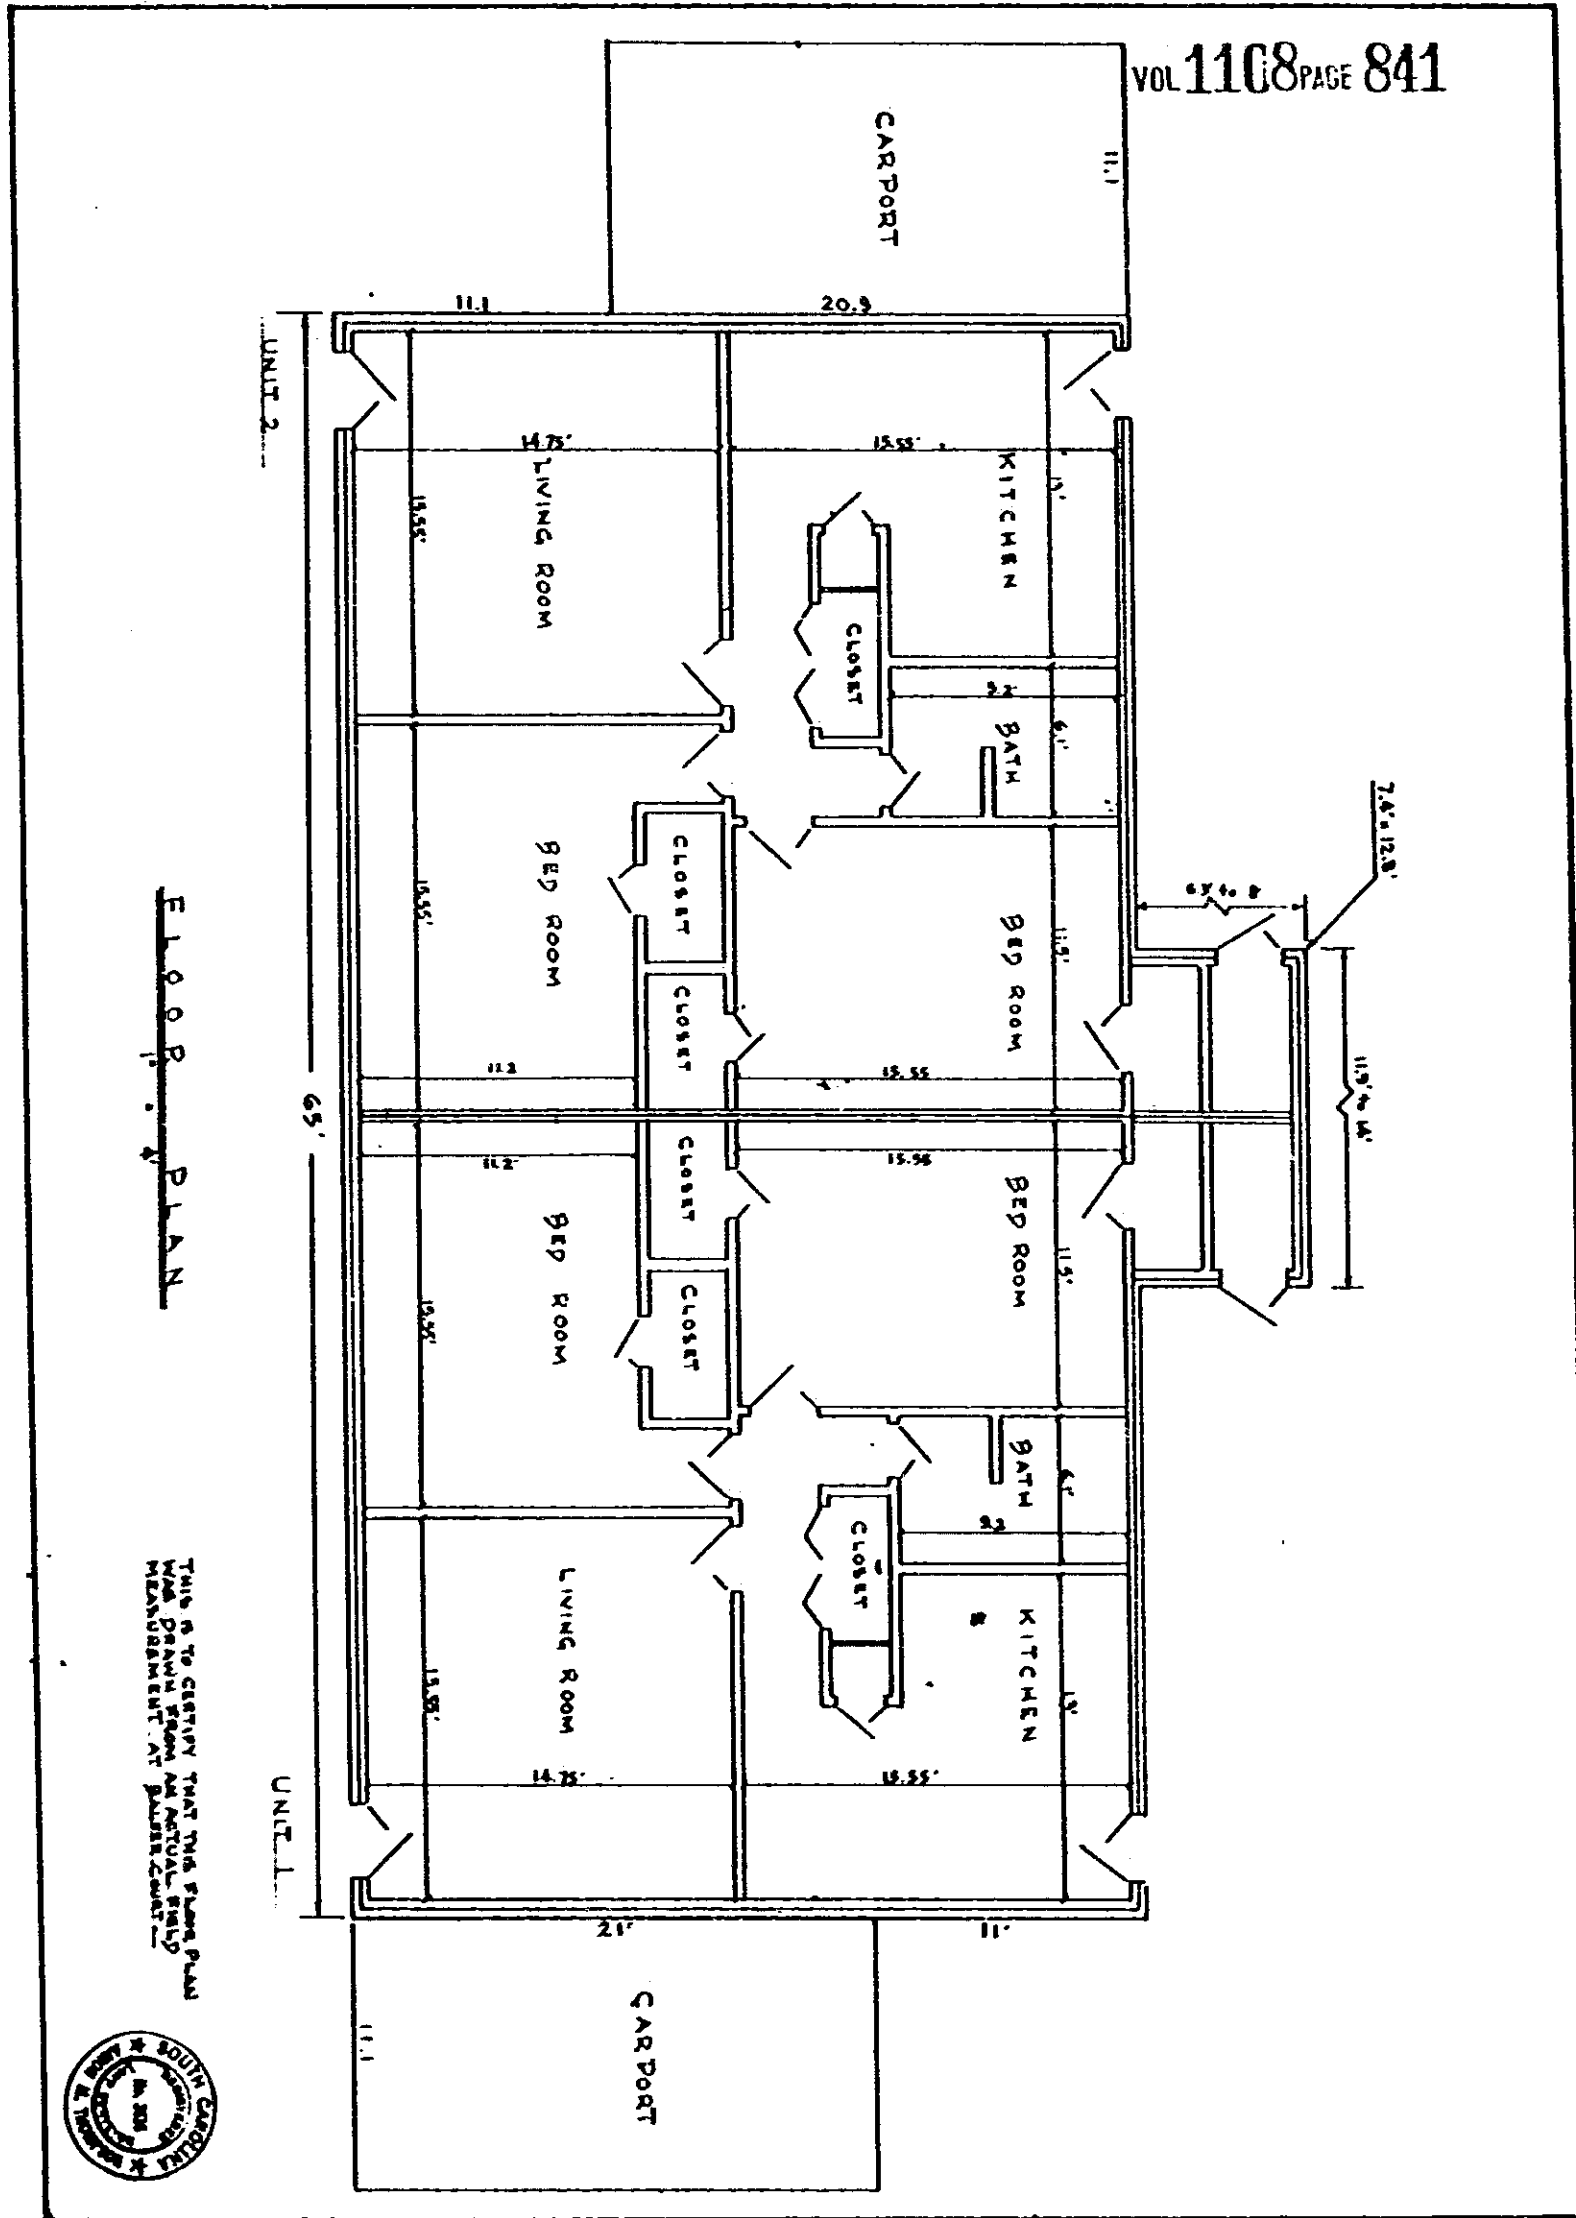

FLOOR PLAN

THIS IS TO CERTIFY THAT THIS FLOOR PLAN WAS DRAWN FROM AN ACTUAL FIELD MEASUREMENT AT BARRACLOUGH



0841

4328 RV-2