


0095

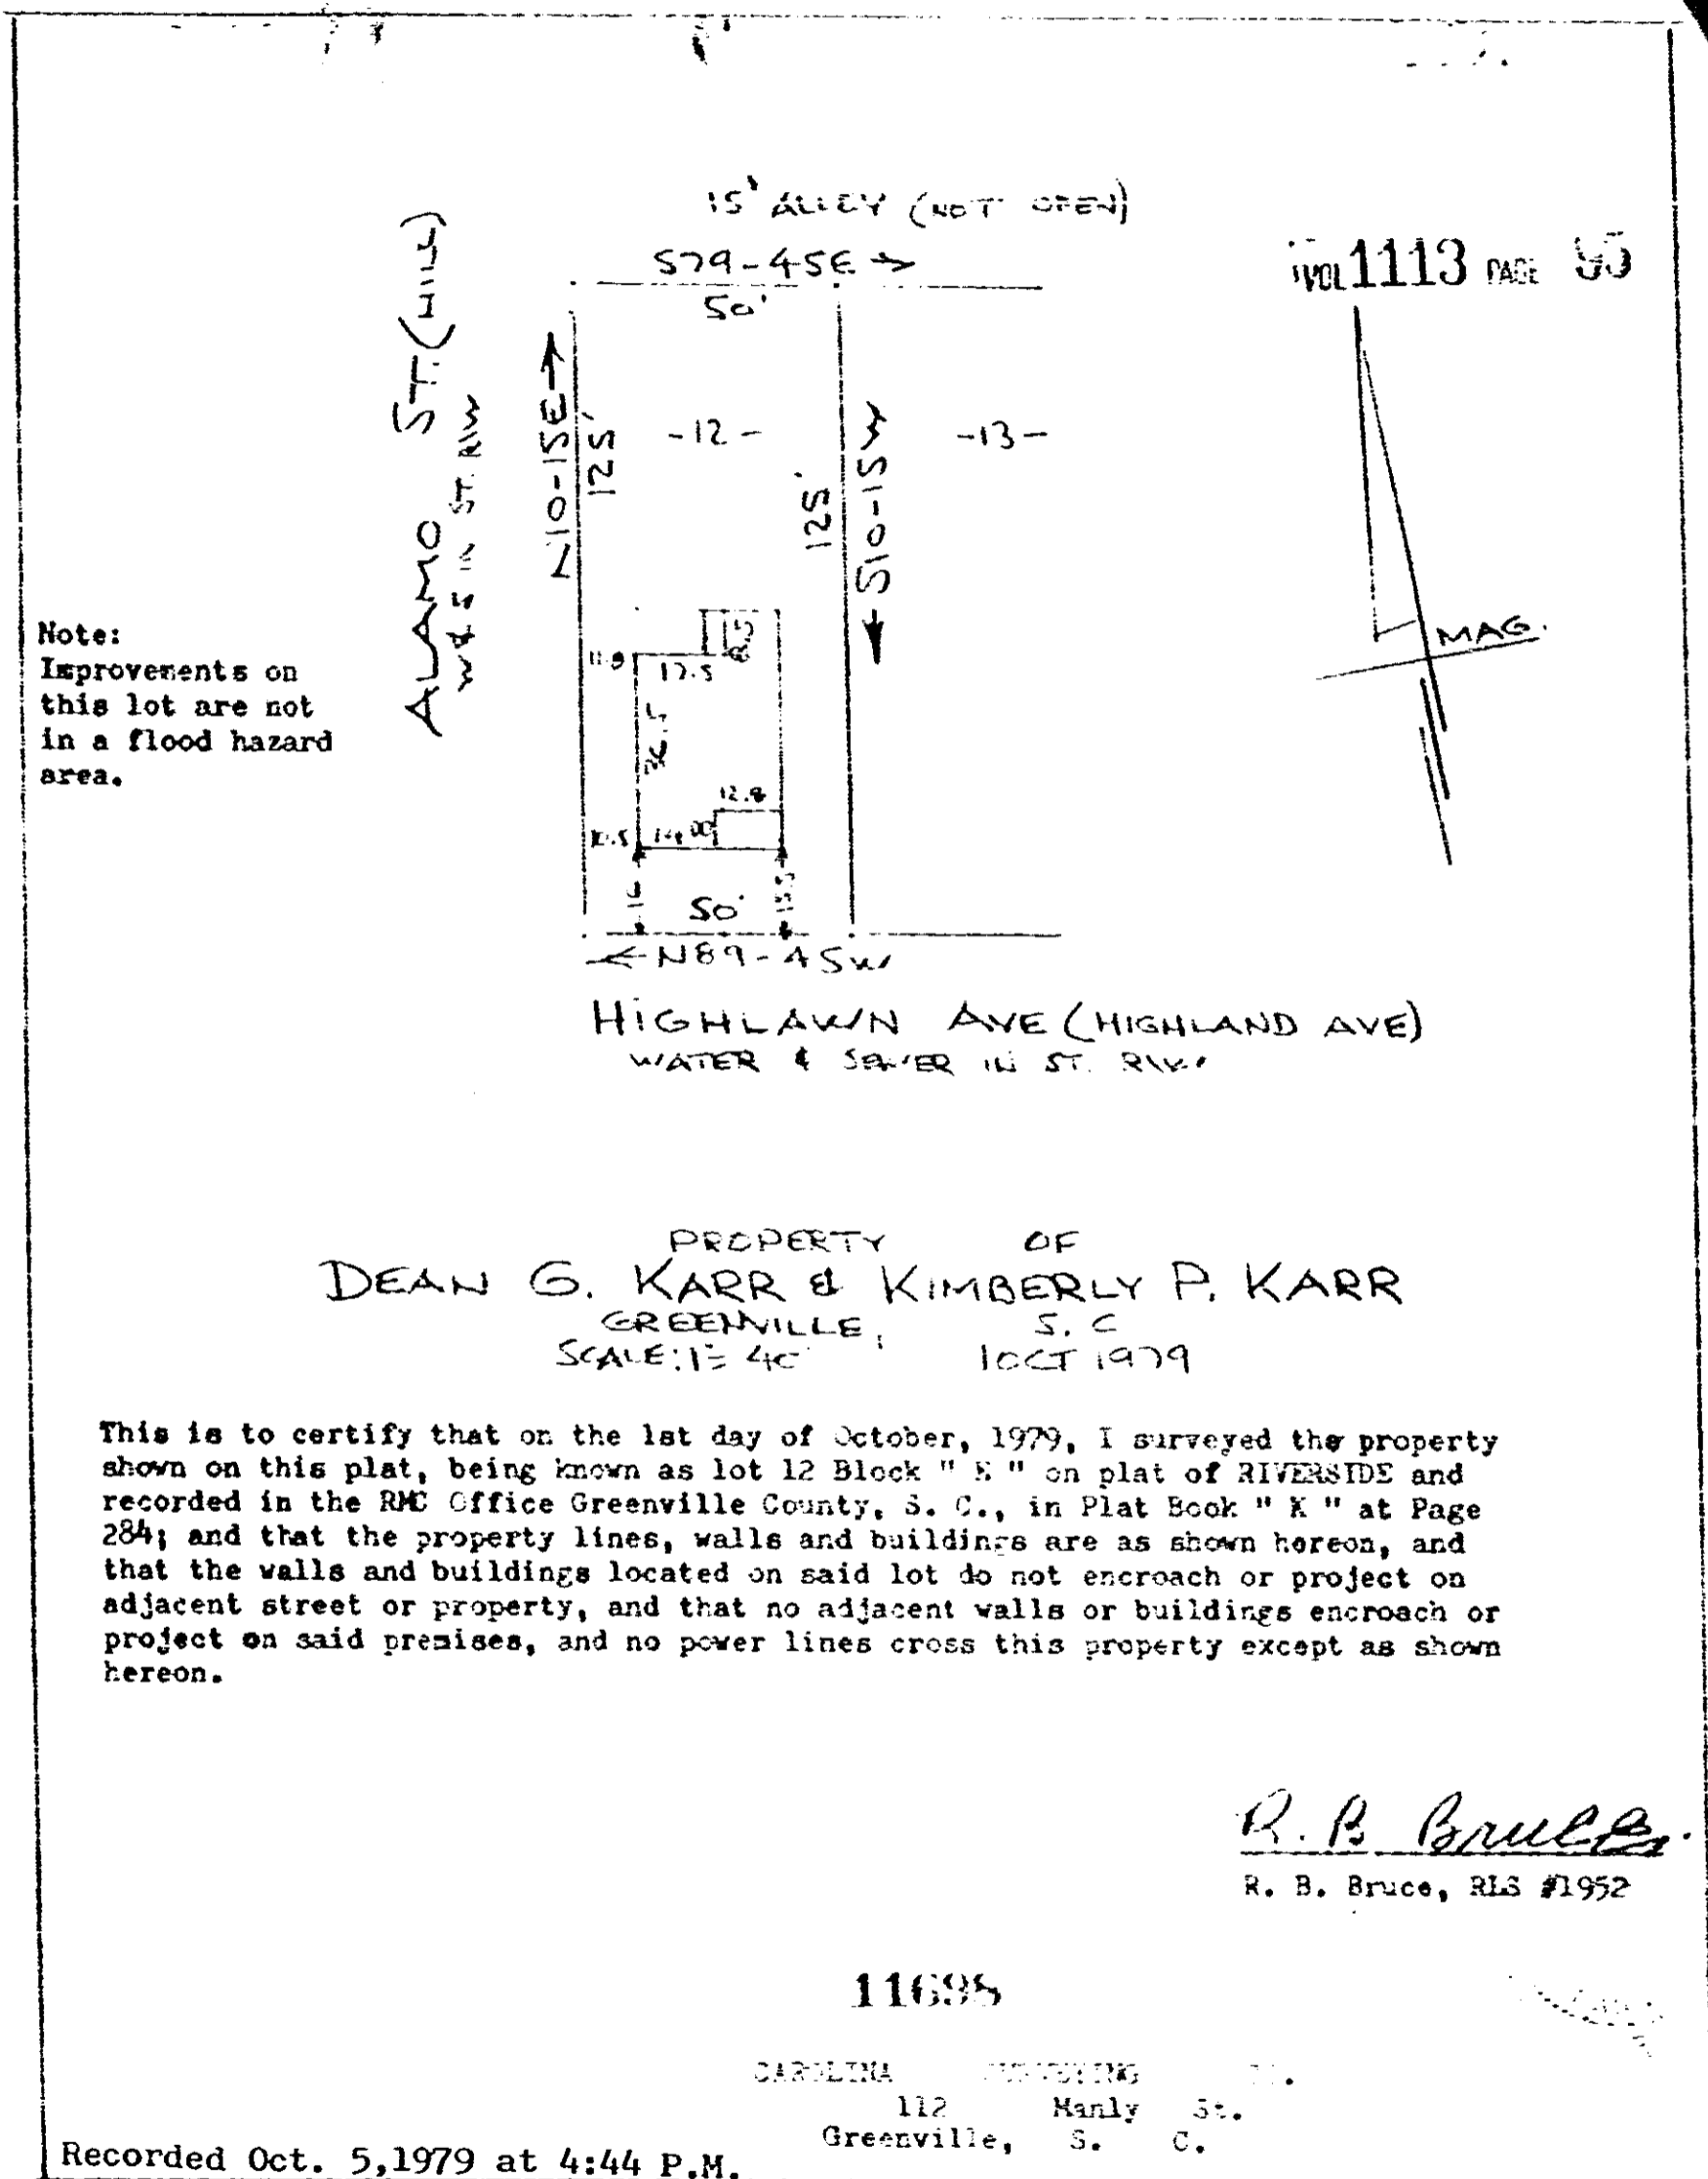

215/37 146-8-22

4328 RV-2