

Name and Post Office Address of Grantor Mr. Julian Carol Bolt
1308 S. Main Street
Greer, South Carolina 29651


Toll Line or Exchange Line tributary to Greer, South Carolina
 (Name) (Exchange)

The Property is bounded where the line enters and leaves this property, by the property of:
Donald James Williams on the North
 and James O. & Edith Moon on the South

Authority P-43377 Classification R45-C
 Area South Carolina

Approved District Manager - Distribution
 Title _____

TAX MAP #
T17.1
BLOCK 1

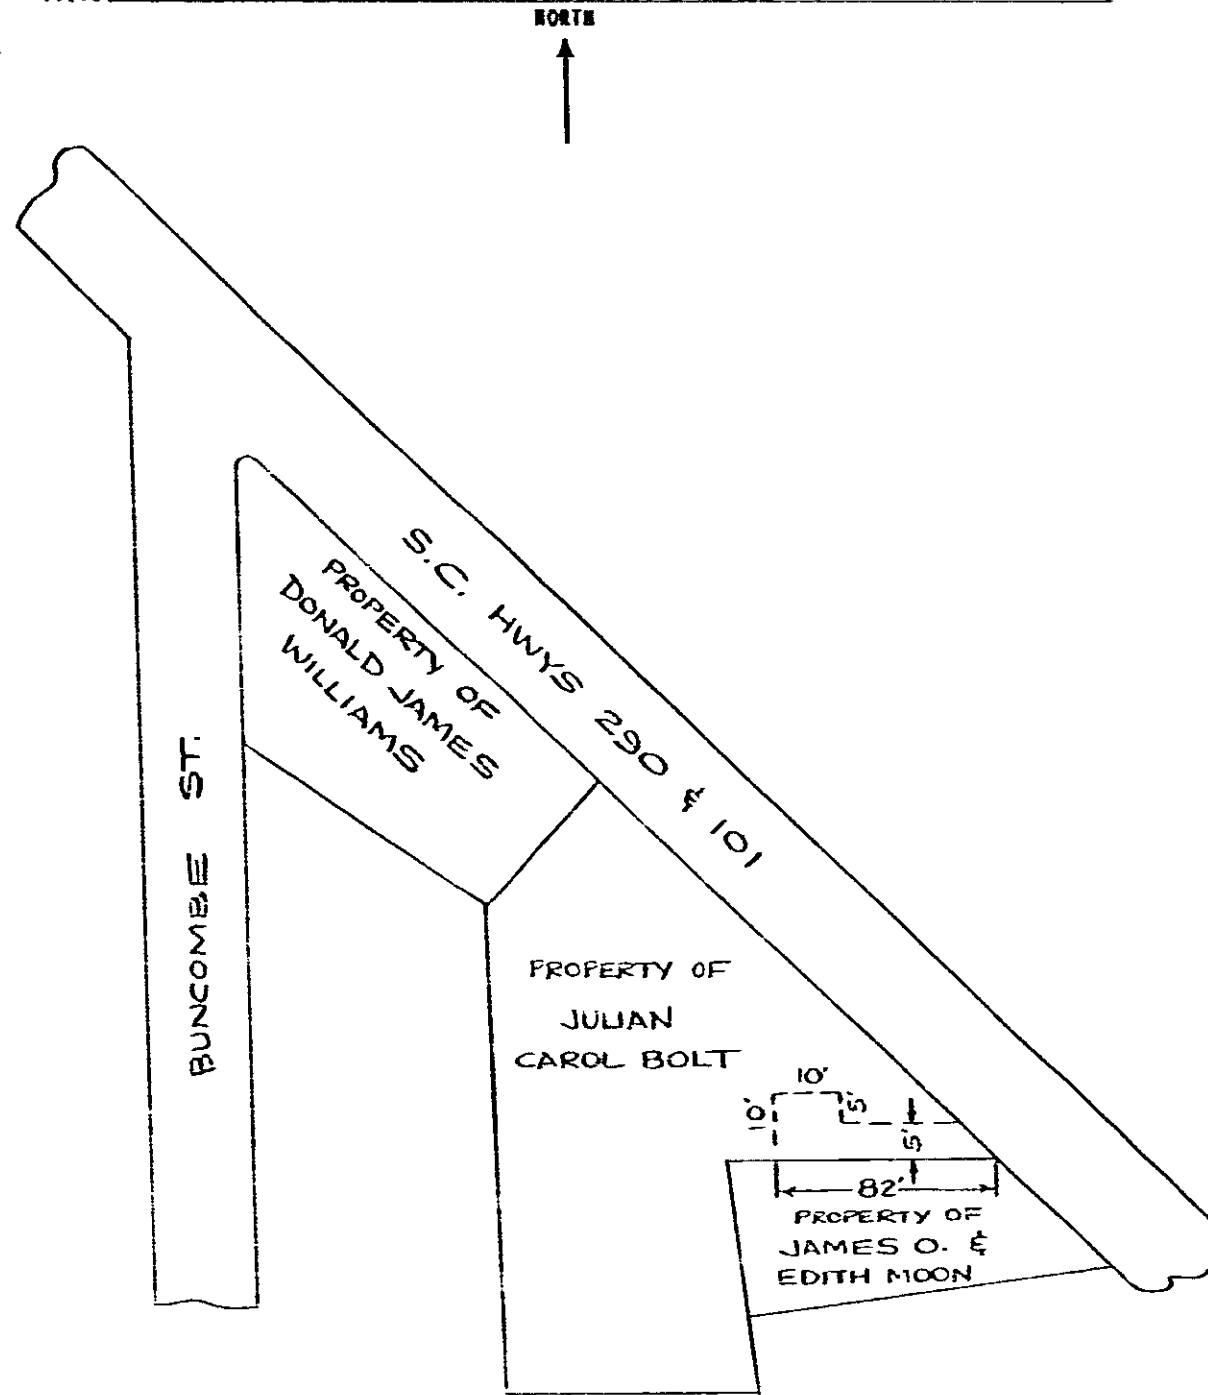

11719

Recorded Oct. 8, 1979 at 10:58 A/M

Booked for record in the office of
 the Clerk of Court, Greenville
 County, S. C. at 10:58 o'clock
 A/M Oct. 8, 1979
 1113
 N. M. C. for C. Co. S. C.

X 11719

4328 RV-2

0216