


VOL 1113 PAGE 844

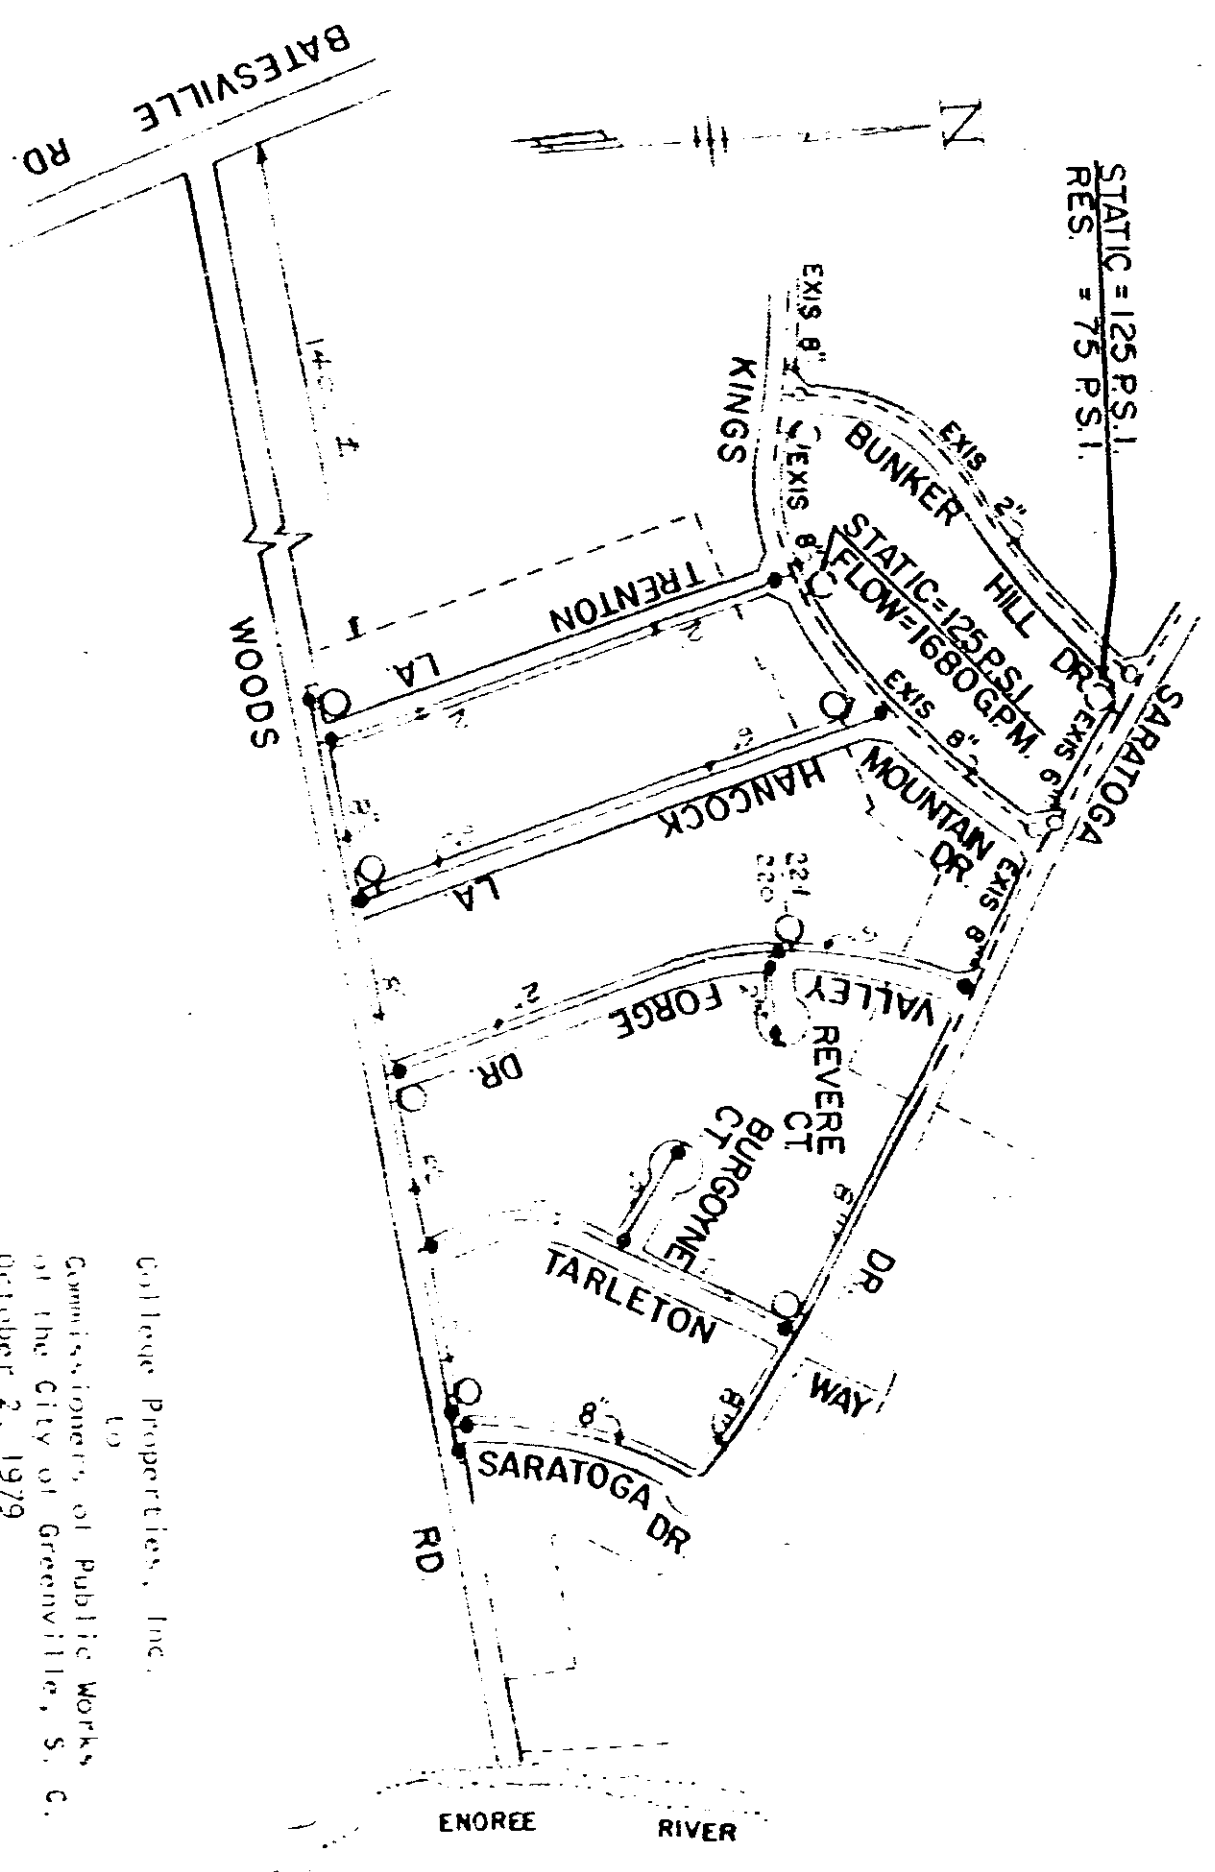

College Properties, Inc.  
 to  
 Commissioners of Public Works  
 of the City of Greenville, S. C.  
 October 2, 1979  
 (BLK. BOOK 534.2-1-34)

Rec. Oct 18, 1979 at 3:05 P.M.

13112

NOTE: ALL 6" & 8" VALS TO OPEN RT.  
 ALL 2" VALS TO OPEN LT.  
 FIRE HYDS. TO BE 3-WAY & OPEN RT.

Material List:

3" D. 1. Pipe	2,770'
6" D. 1. Pipe	1,480'
6" C. 1. Pipe	40'
2" Galv. Pipe	2,860'
3" Valves	2
6" Valves	10
2" Valves	12
Fire Hydrants	7

CANEBRAKE PHASE II  
 APR., 1979 SCALE 1" = 400'