

Name and Post Office Address of Grantor  
C. P. MANLY  
RT. 9 MANLY DR.  
GREENVILLE S.C. 29609

Toll Line or Exchange Line tributary to  
GREENVILLE, SOUTH CAROLINA

The Property is bounded where the line enters and leaves this property by the property of:

EDITH B. MCLEAN on the SOUTH  
and THE CITY OF GREENVILLE on the NORTH


Authority C-653B Classification 45-C

Area Greenville, South Carolina

Approved \_\_\_\_\_

Title District Manager/Distribution

NORTH

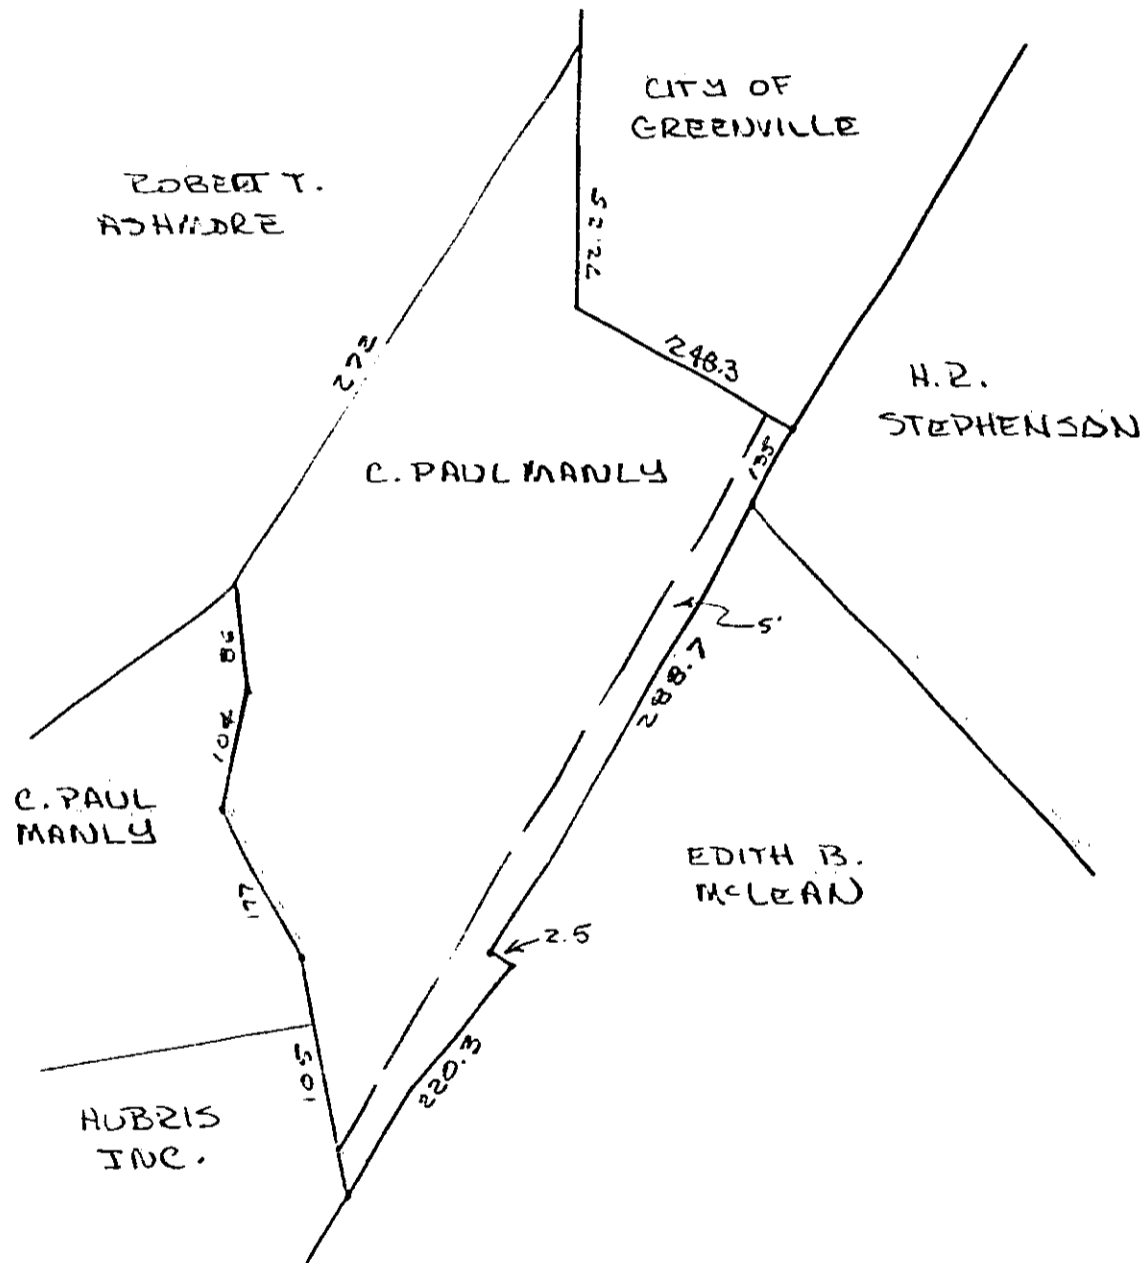

STATE OF SOUTH CAROLINA  
DOCUMENTARY TAX STAMP  
NOV 27 1979

GREENVILLE COUNTY  
8 0 0 0 8 0

SOUTH CAROLINA COUNTY DOCUMENTARY TAX  
NOV 27 79  
PB. 16911  
00.55

RECORDED NOV 27 1979 at 3:43 P.M.

Filed for record in the office of the R. M. C. for Greenville County, S. C. at 3:43 P.M. NOV. 26, 1979 and recorded in Deed Book 1116 at page 486

17725


4328 RV-2

2870