


BOOK 1140 PAGE 81

Name and
 First Office Address
 of Applicant: Illar A. Coleman
100 Crestone Drive
Greenville, S. C. 29611
 Title: Crestone SAC Interface
 City: Greenville, S. C.
 Exchange Line: _____
 Tributary to: _____

The Property is bounded where the line enters and leaves this property by the corners of
Crestone Drive Southwest
Valley Street Southeast
 Subdiv. No. P-43350 R45C
 State: South Carolina

Approved: _____
 Title: District Manager - Distribution

NORTH

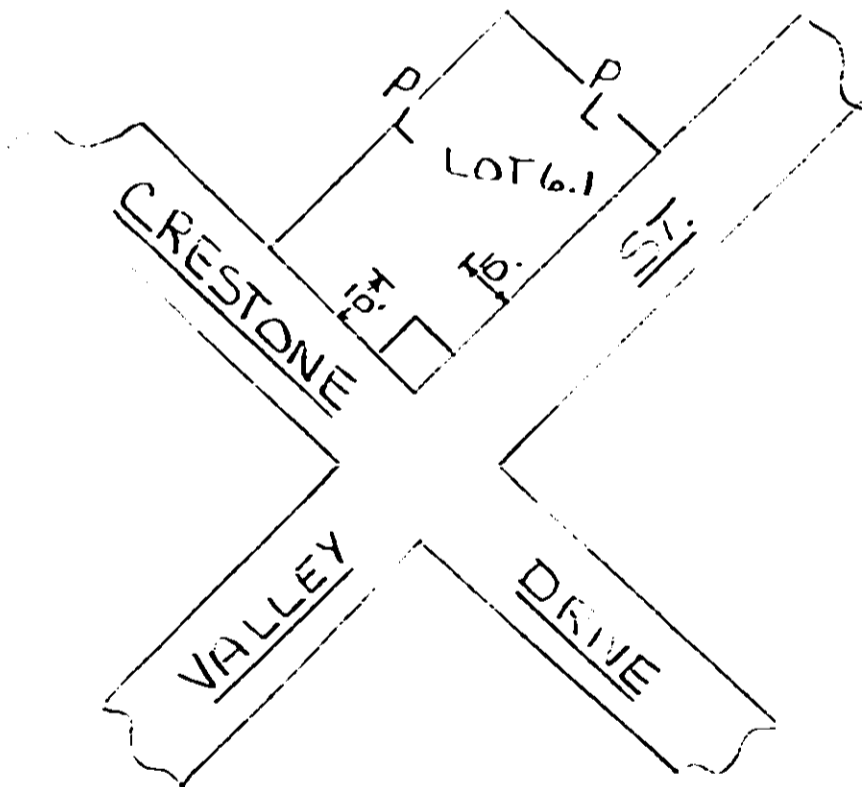

MAP 226
BLOCK 6
LOT 6.1

RECORDED APR 10 1981

at 1:55 P.M. 285-16

5
0.08
0.0

4328 RV-23