

BOOK 1148 PAGE 999

Name and Post Office Address of Grantor BILLIE & MAMIE L. CRAN
217 McDONALD STREET
GREENVILLE, S.C. 29609

Toll Line or Exchange Line tributary to GREENVILLE, SOUTH CAROLINA
(Name) (Exchange)

The Property is bounded where the line enters and leaves this property by the property of:
RUSSELL T. MABLE BUTLER on the NORTH
 and N. PARK DRIVE on the WEST


Authority _____ Classification R45C
 Area GREENVILLE, SOUTH CAROLINA

Approved _____
 Title _____

33113

MAY 29 1981

57
90
90
0.

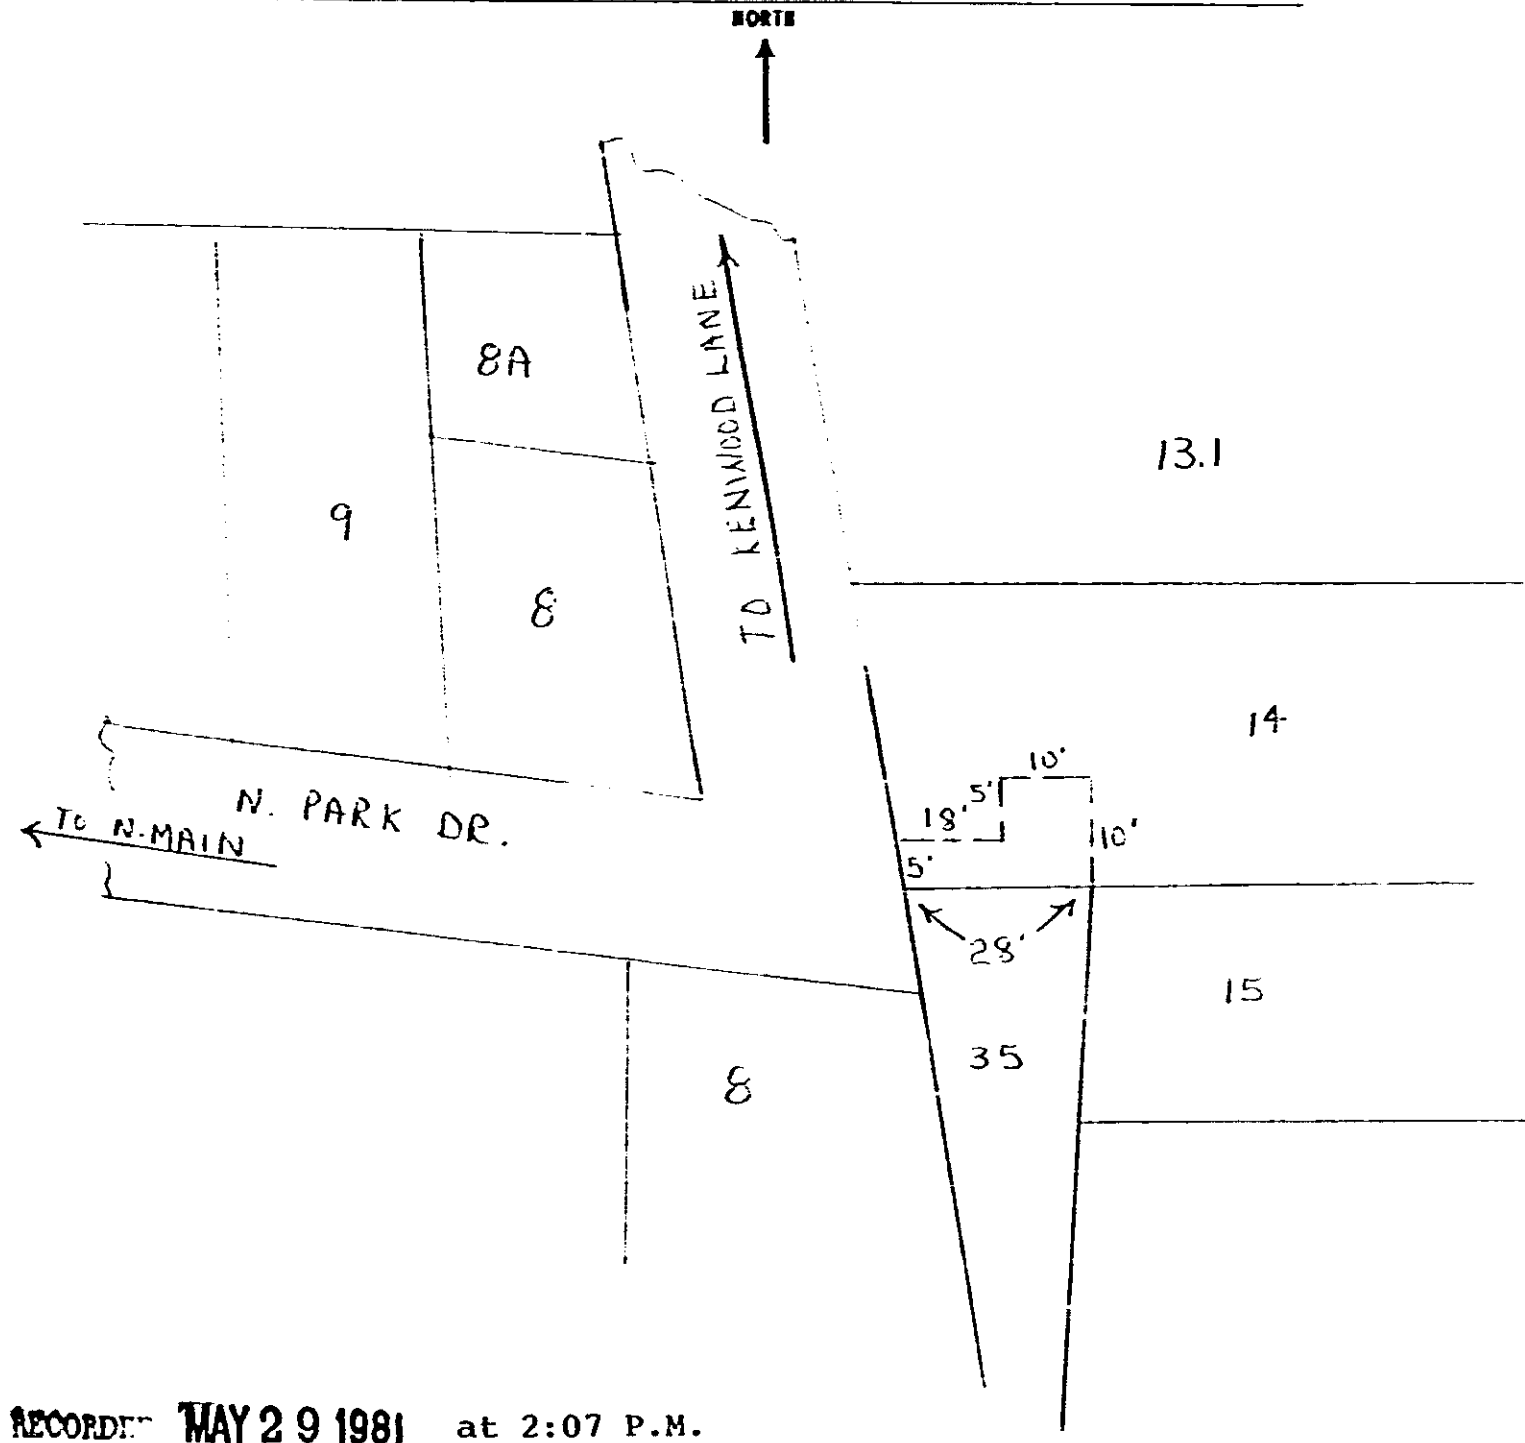

RECORDED MAY 29 1981 at 2:07 P.M.

33113

4328 RV-2