


LIMITED COMMON ELEMENTS

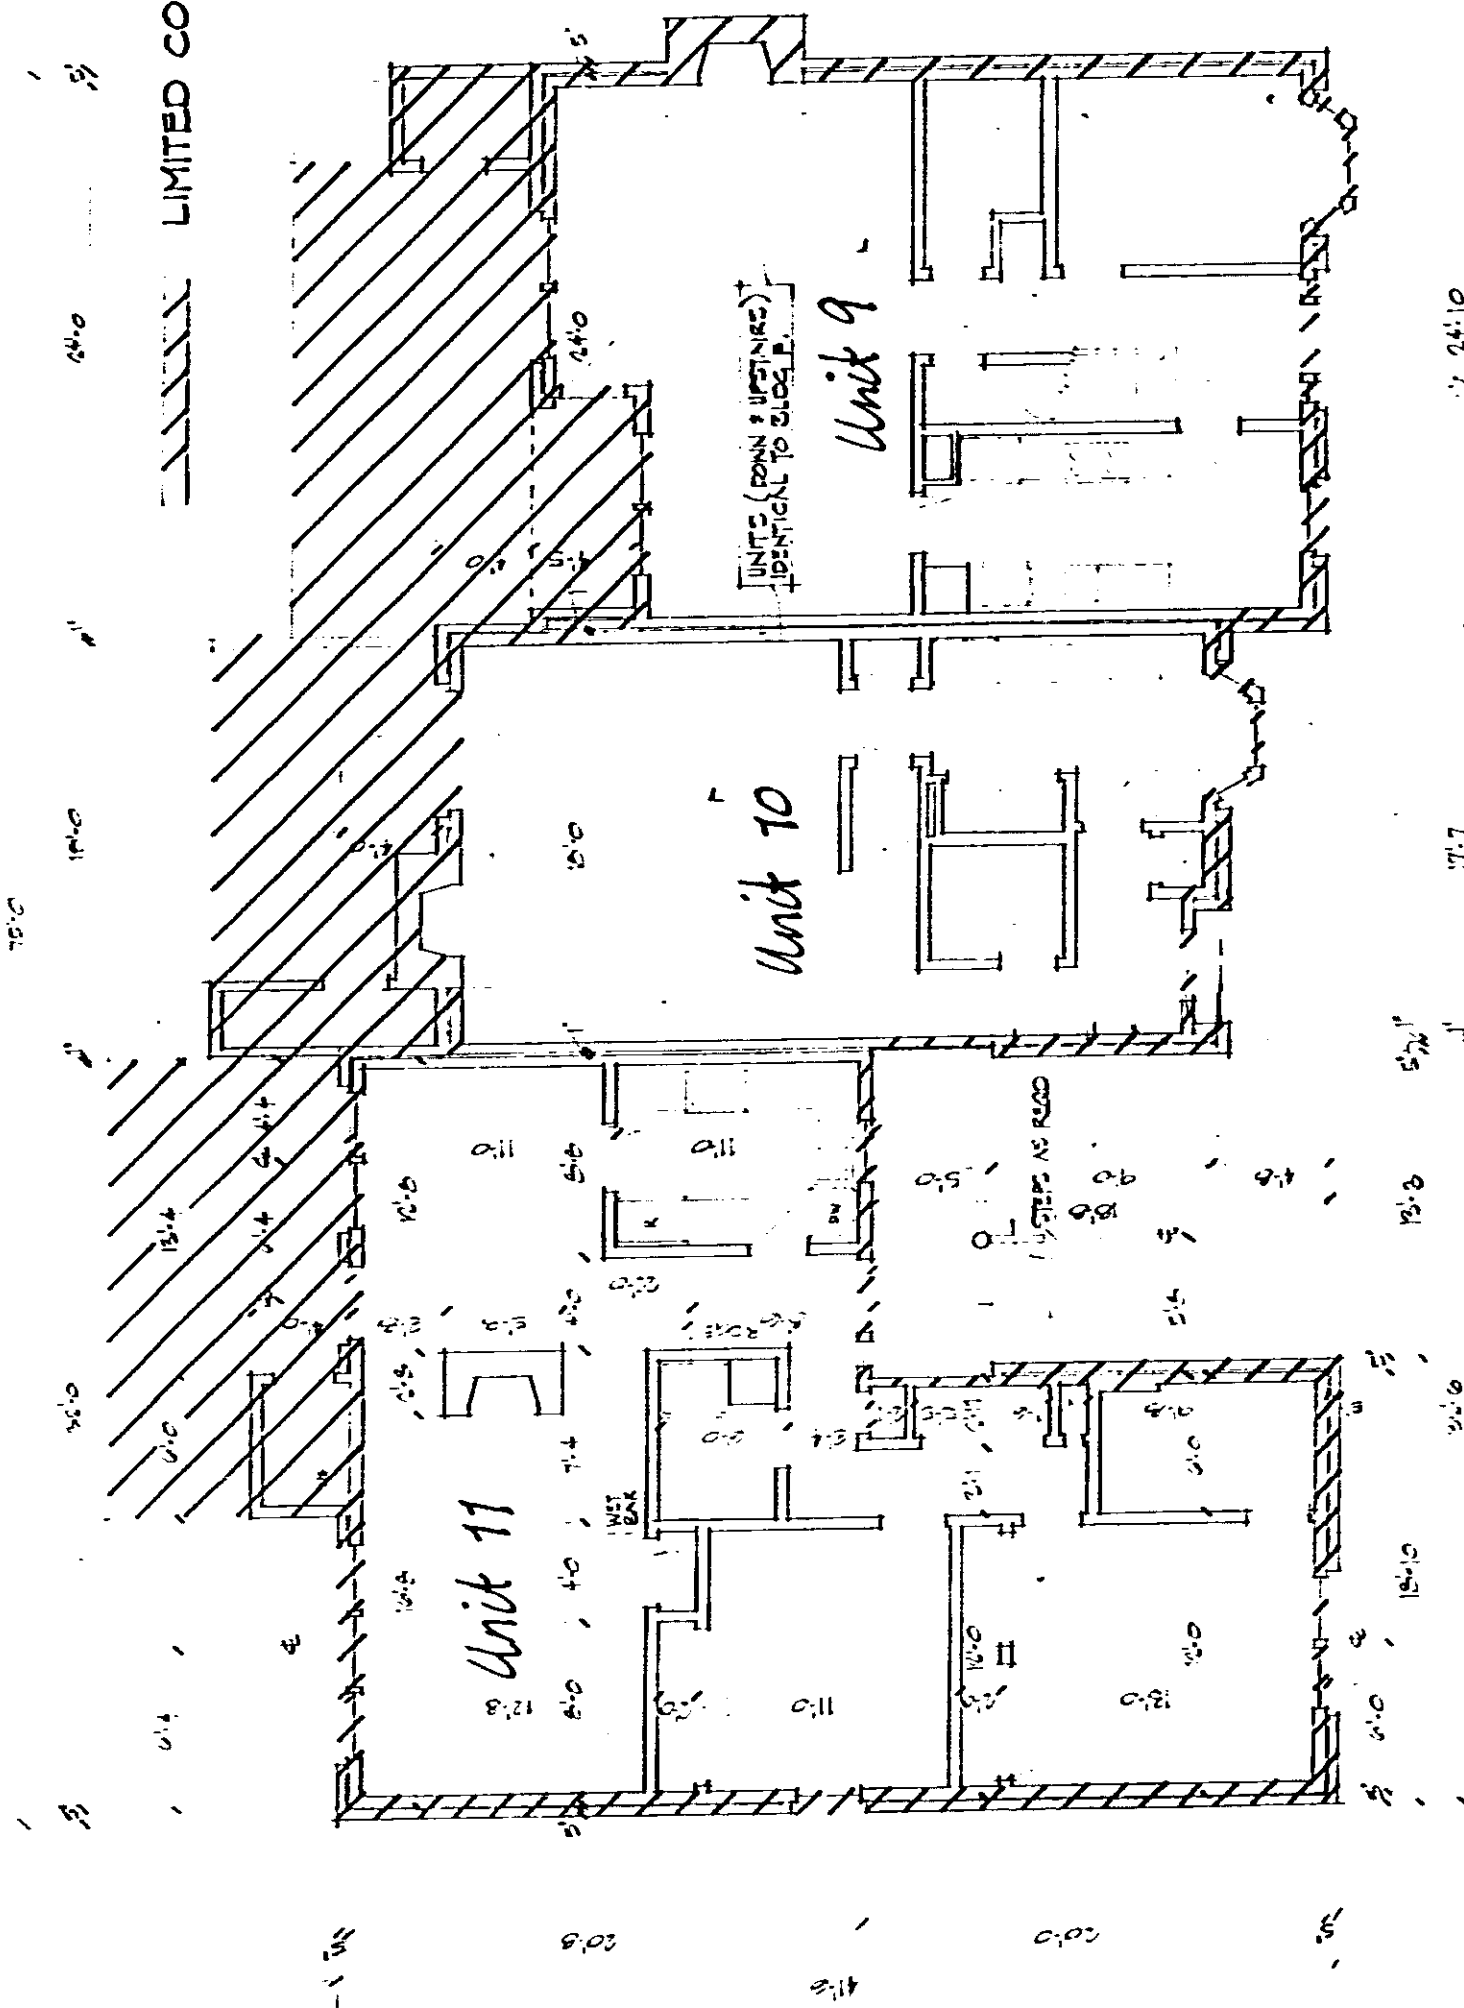

1151-31

PLAN - BLDG D



CERTIFICATE

I, Wade H. Barber, do hereby certify that these plans fully depict within reasonable construction tolerances the layout, location, letter identification and dimensions of the buildings and dwellings contained therein. *Wade H. Barber*

FIRST FLOOR
BLACK VENER
SEE BLDG P FOR SECOND FLOOR

SEE BLDG P FOR DETAILS



4328 RV.2

008