


LIMITED COMMON ELEMENTS

1151 86

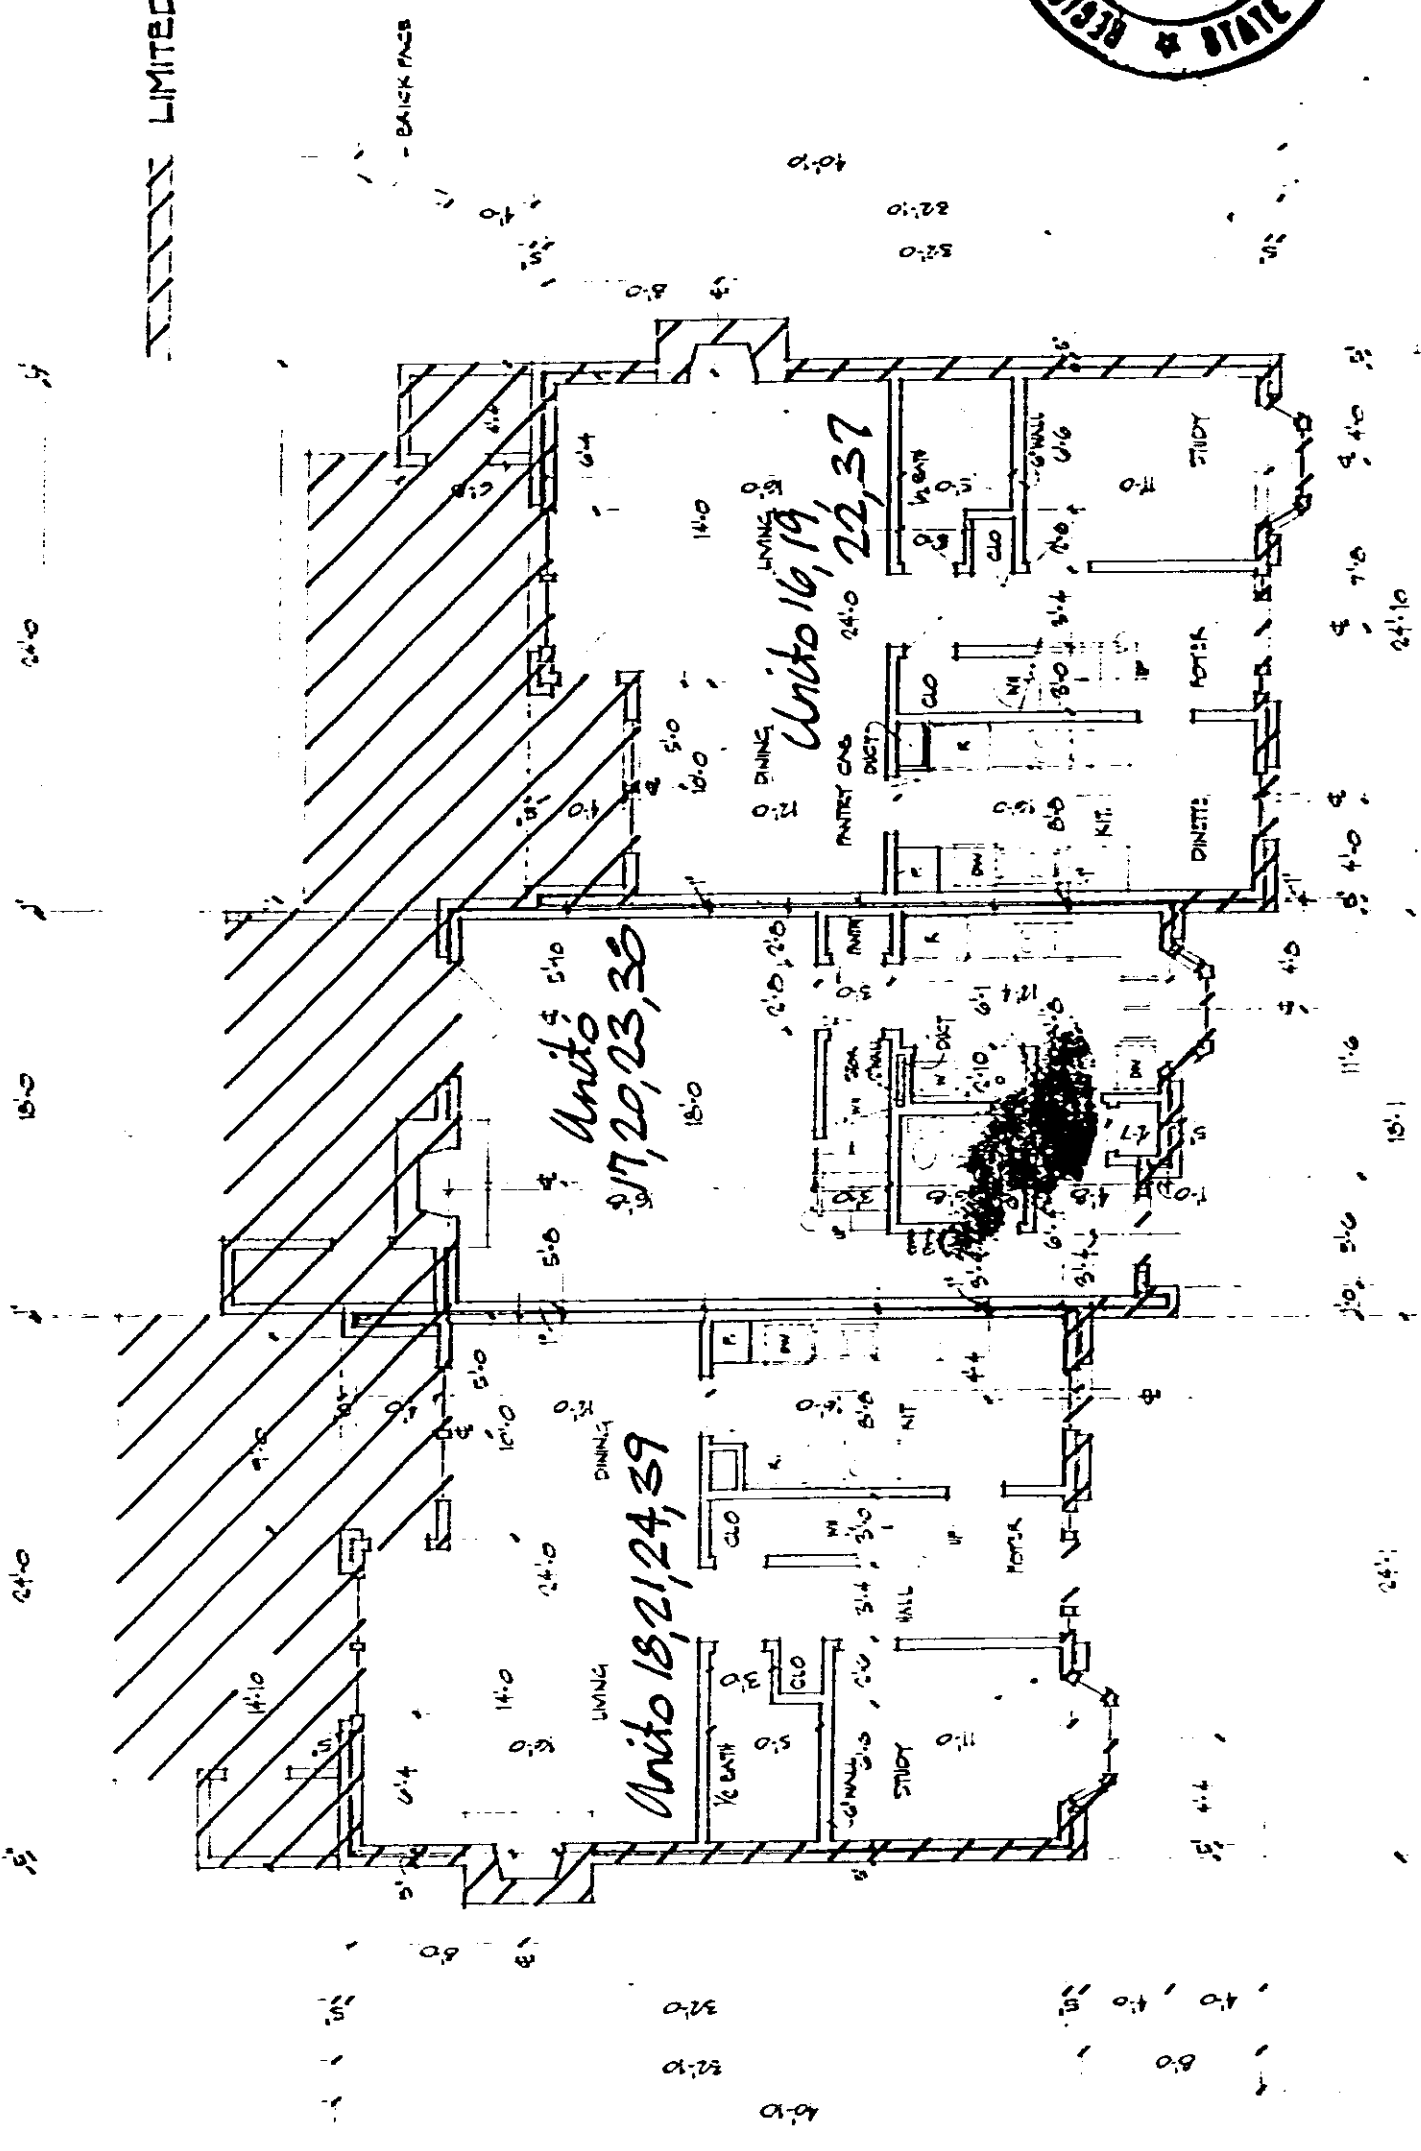

PLAN: BLDG. F.
DATE: 12-1-10



REVISION NOTE: 5/3/01
DELETE BACK VENEER & BLDG. F.F.A.
SHOW & SITE PLAN & FINISH SITE PLAN
BY THE SIDING.

FIRST FLOOR

CERTIFICATE

I, Wade H. Barber, do hereby certify that these plans fully depict within reasonable construction tolerances the layout, location, letter identification and dimensions of the buildings and dwellings contained therein.

Wade H. Barber

4328 RV-2