


LIMITED COMMON ELEMENTS

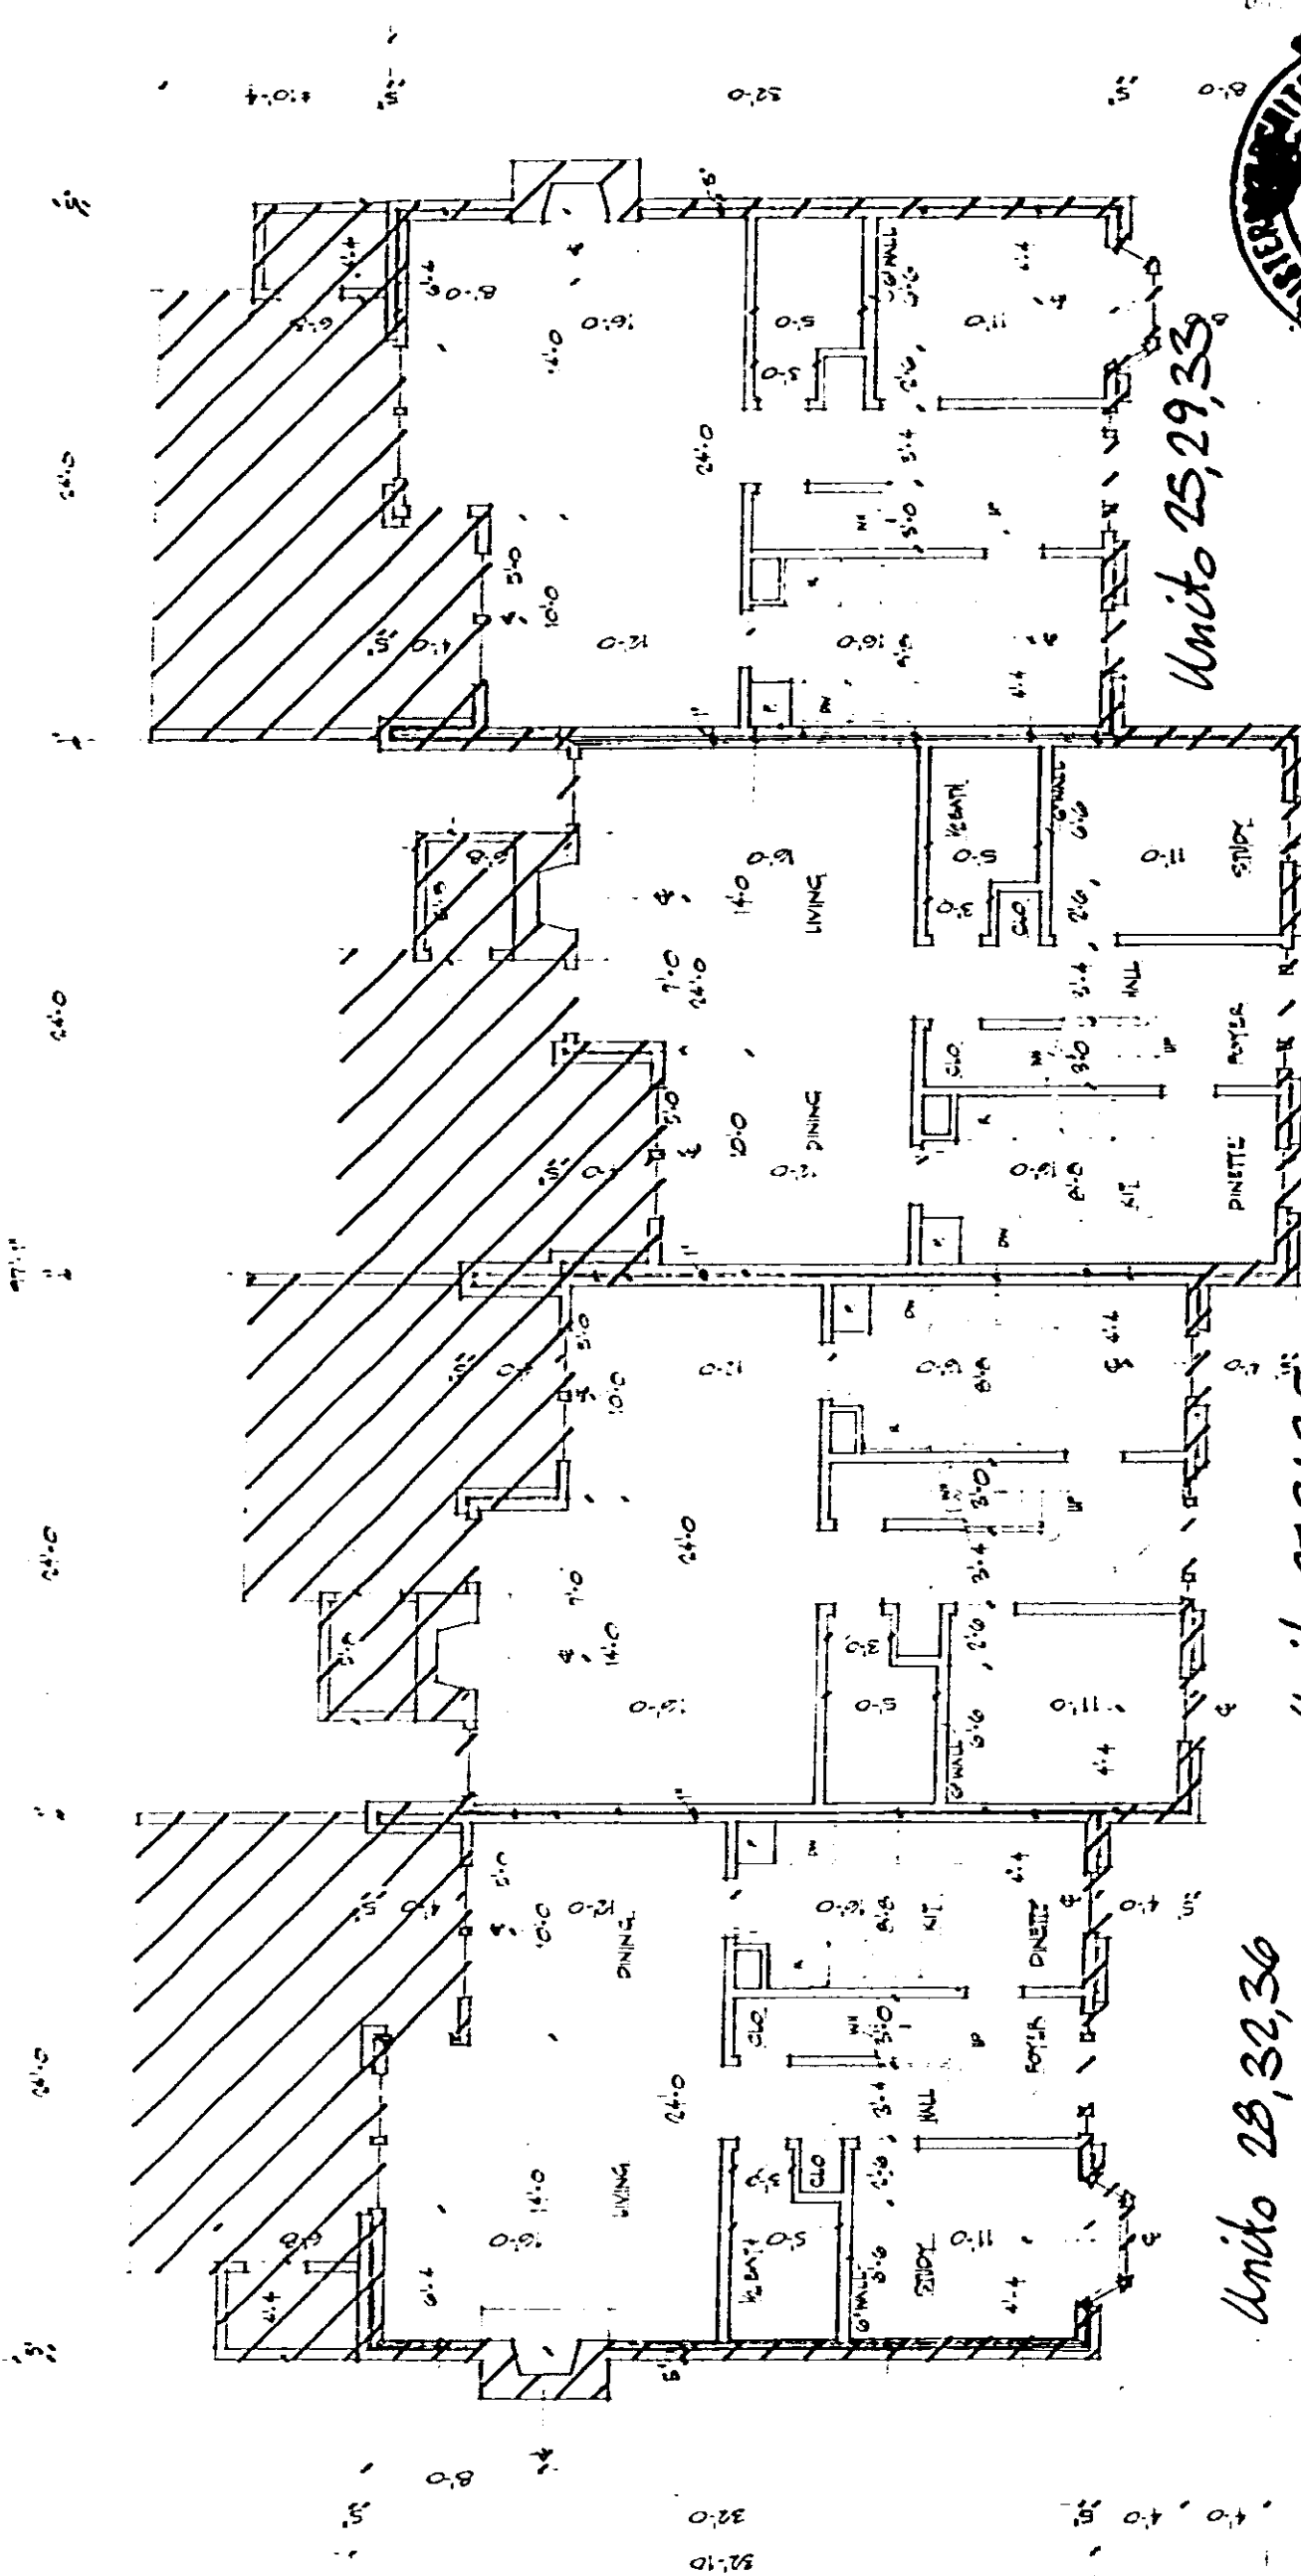

Unito 25, 29, 33

Unito 26, 30, 34

Unito 27, 31, 35

Unito 28, 32, 36





FIRST FLOOR



CERTIFICATE

I, Wade H. Barber, do hereby certify that these plans fully depict within reasonable construction tolerances the layout, location, letter identification and dimensions of the buildings and dwellings contained therein.

Wade H. Barber

4328 RV.2

009

1151 91