


060

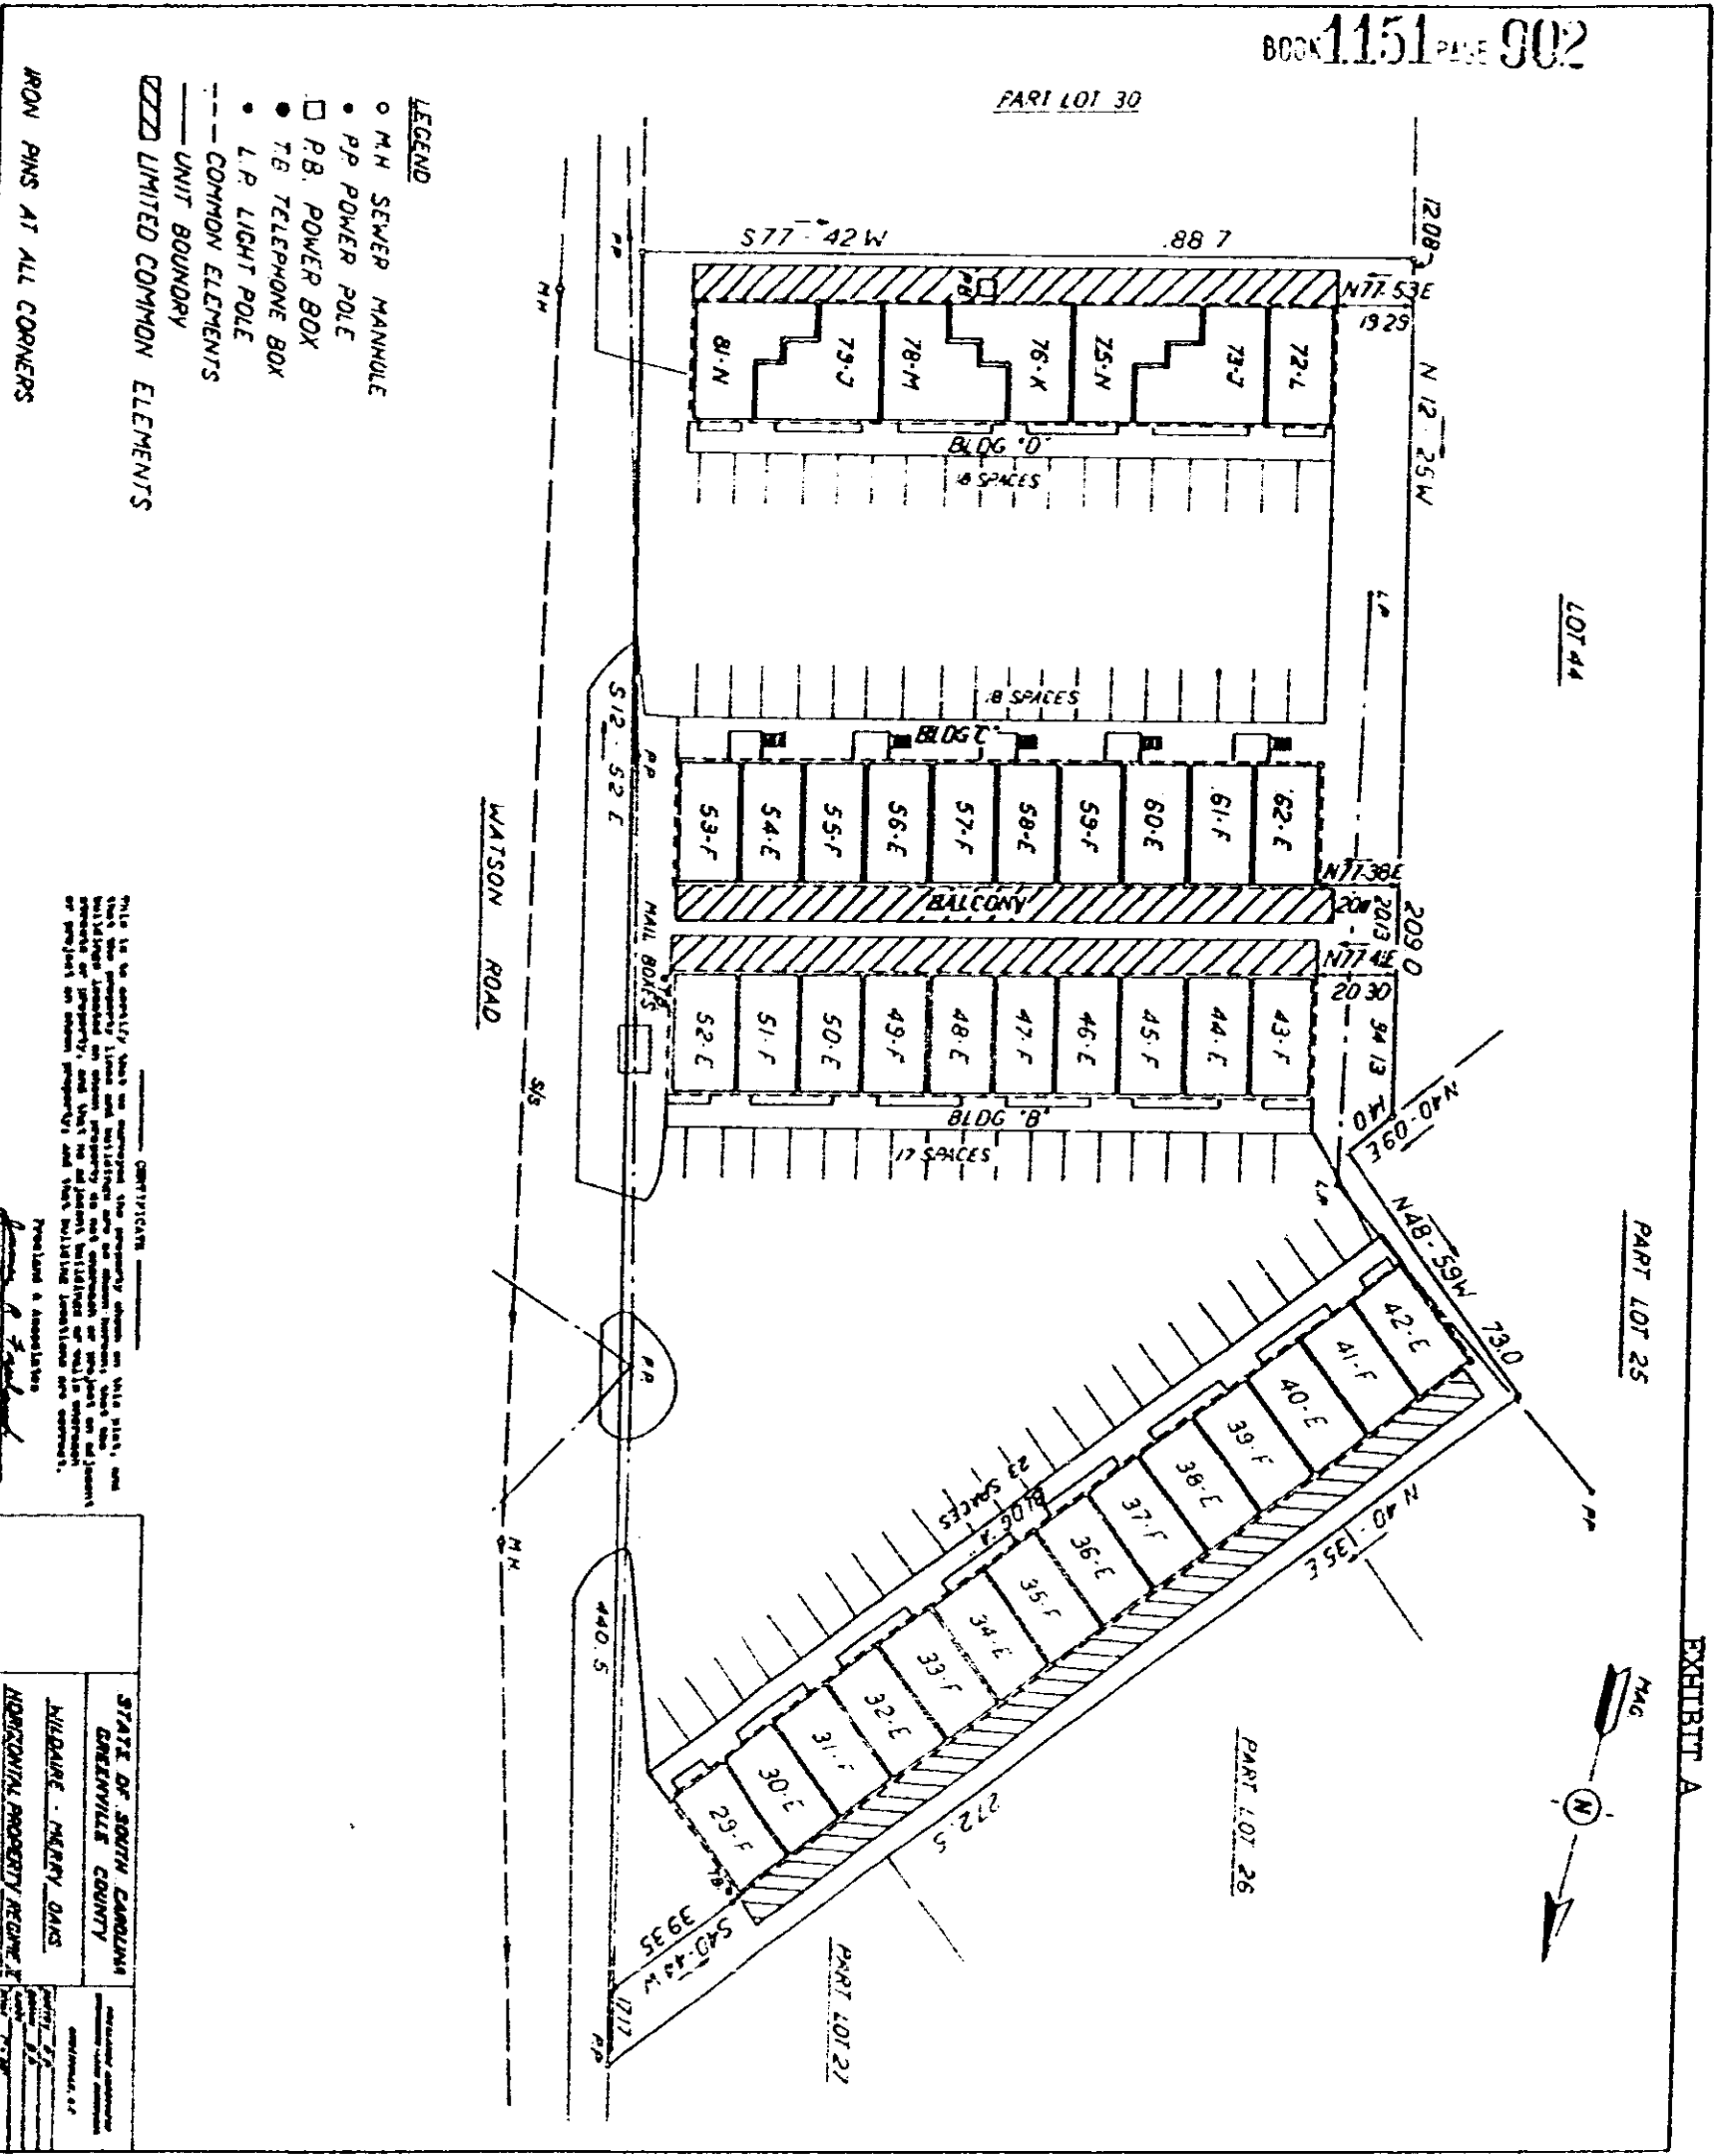

- LEGEND**
- M.H. SEWER MANHOLE
 - P.P. POWER POLE
 - P.B. POWER BOX
 - T.B. TELEPHONE BOX
 - L.P. LIGHT POLE
 - COMMON ELEMENTS
 - UNIT BOUNDARY
 - ▨ LIMITED COMMON ELEMENTS
- IRON PINS AT ALL CORNERS

CERTIFICATE



Prepared & Assisted by
[Signature]


EXHIBIT A