

BOOK 1157 PAGE 608


Name and Post Office Address of Grantor Julia E. Stevens File No. _____
21 Rebecca Street
Greenville, SC 29607

Toll Line or Exchange Line tributary to _____ (Name)
_____ (Exchange)

The Property is bounded where the line enters and leaves this property by the property of:
David & Dorothy Sullivan on the East
and R. C. Gamble on the South

Authority HF1-B513F Classification 1C
Area South Carolina

Approved [Signature]
Title District Manager - Distribution

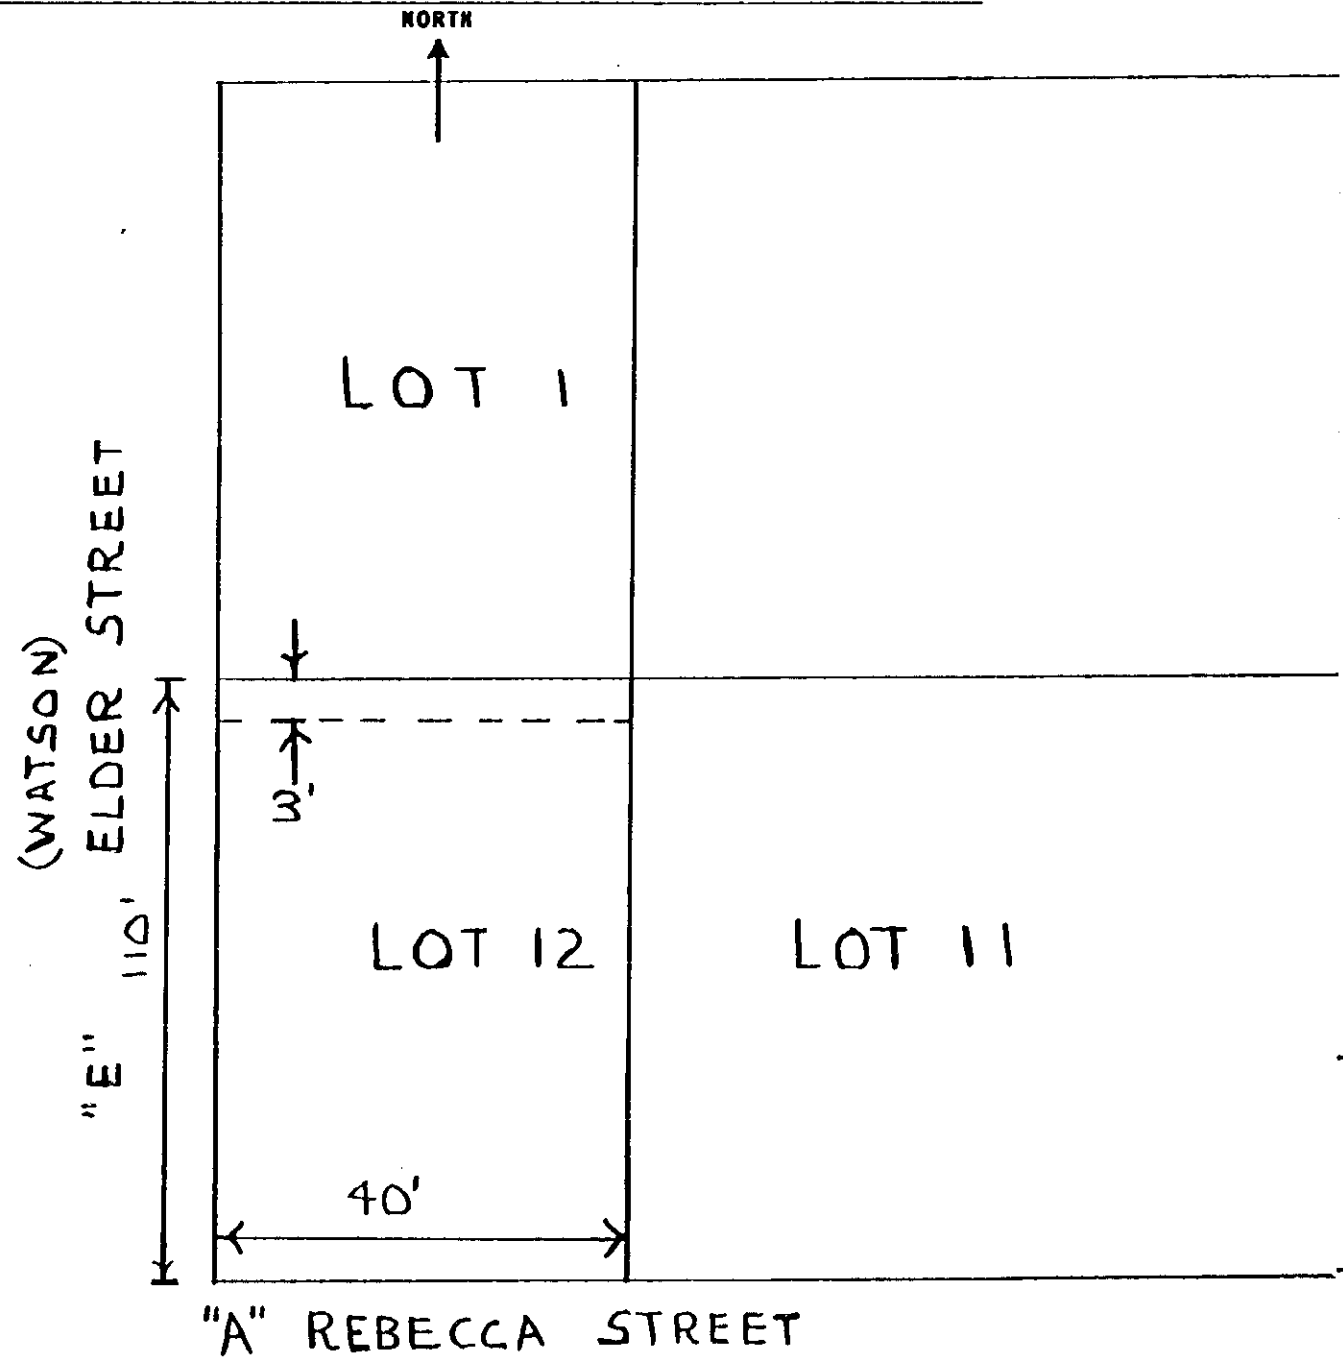

(CONTINUED ON NEXT PAGE)

150.00

4326 RV-2