


2980

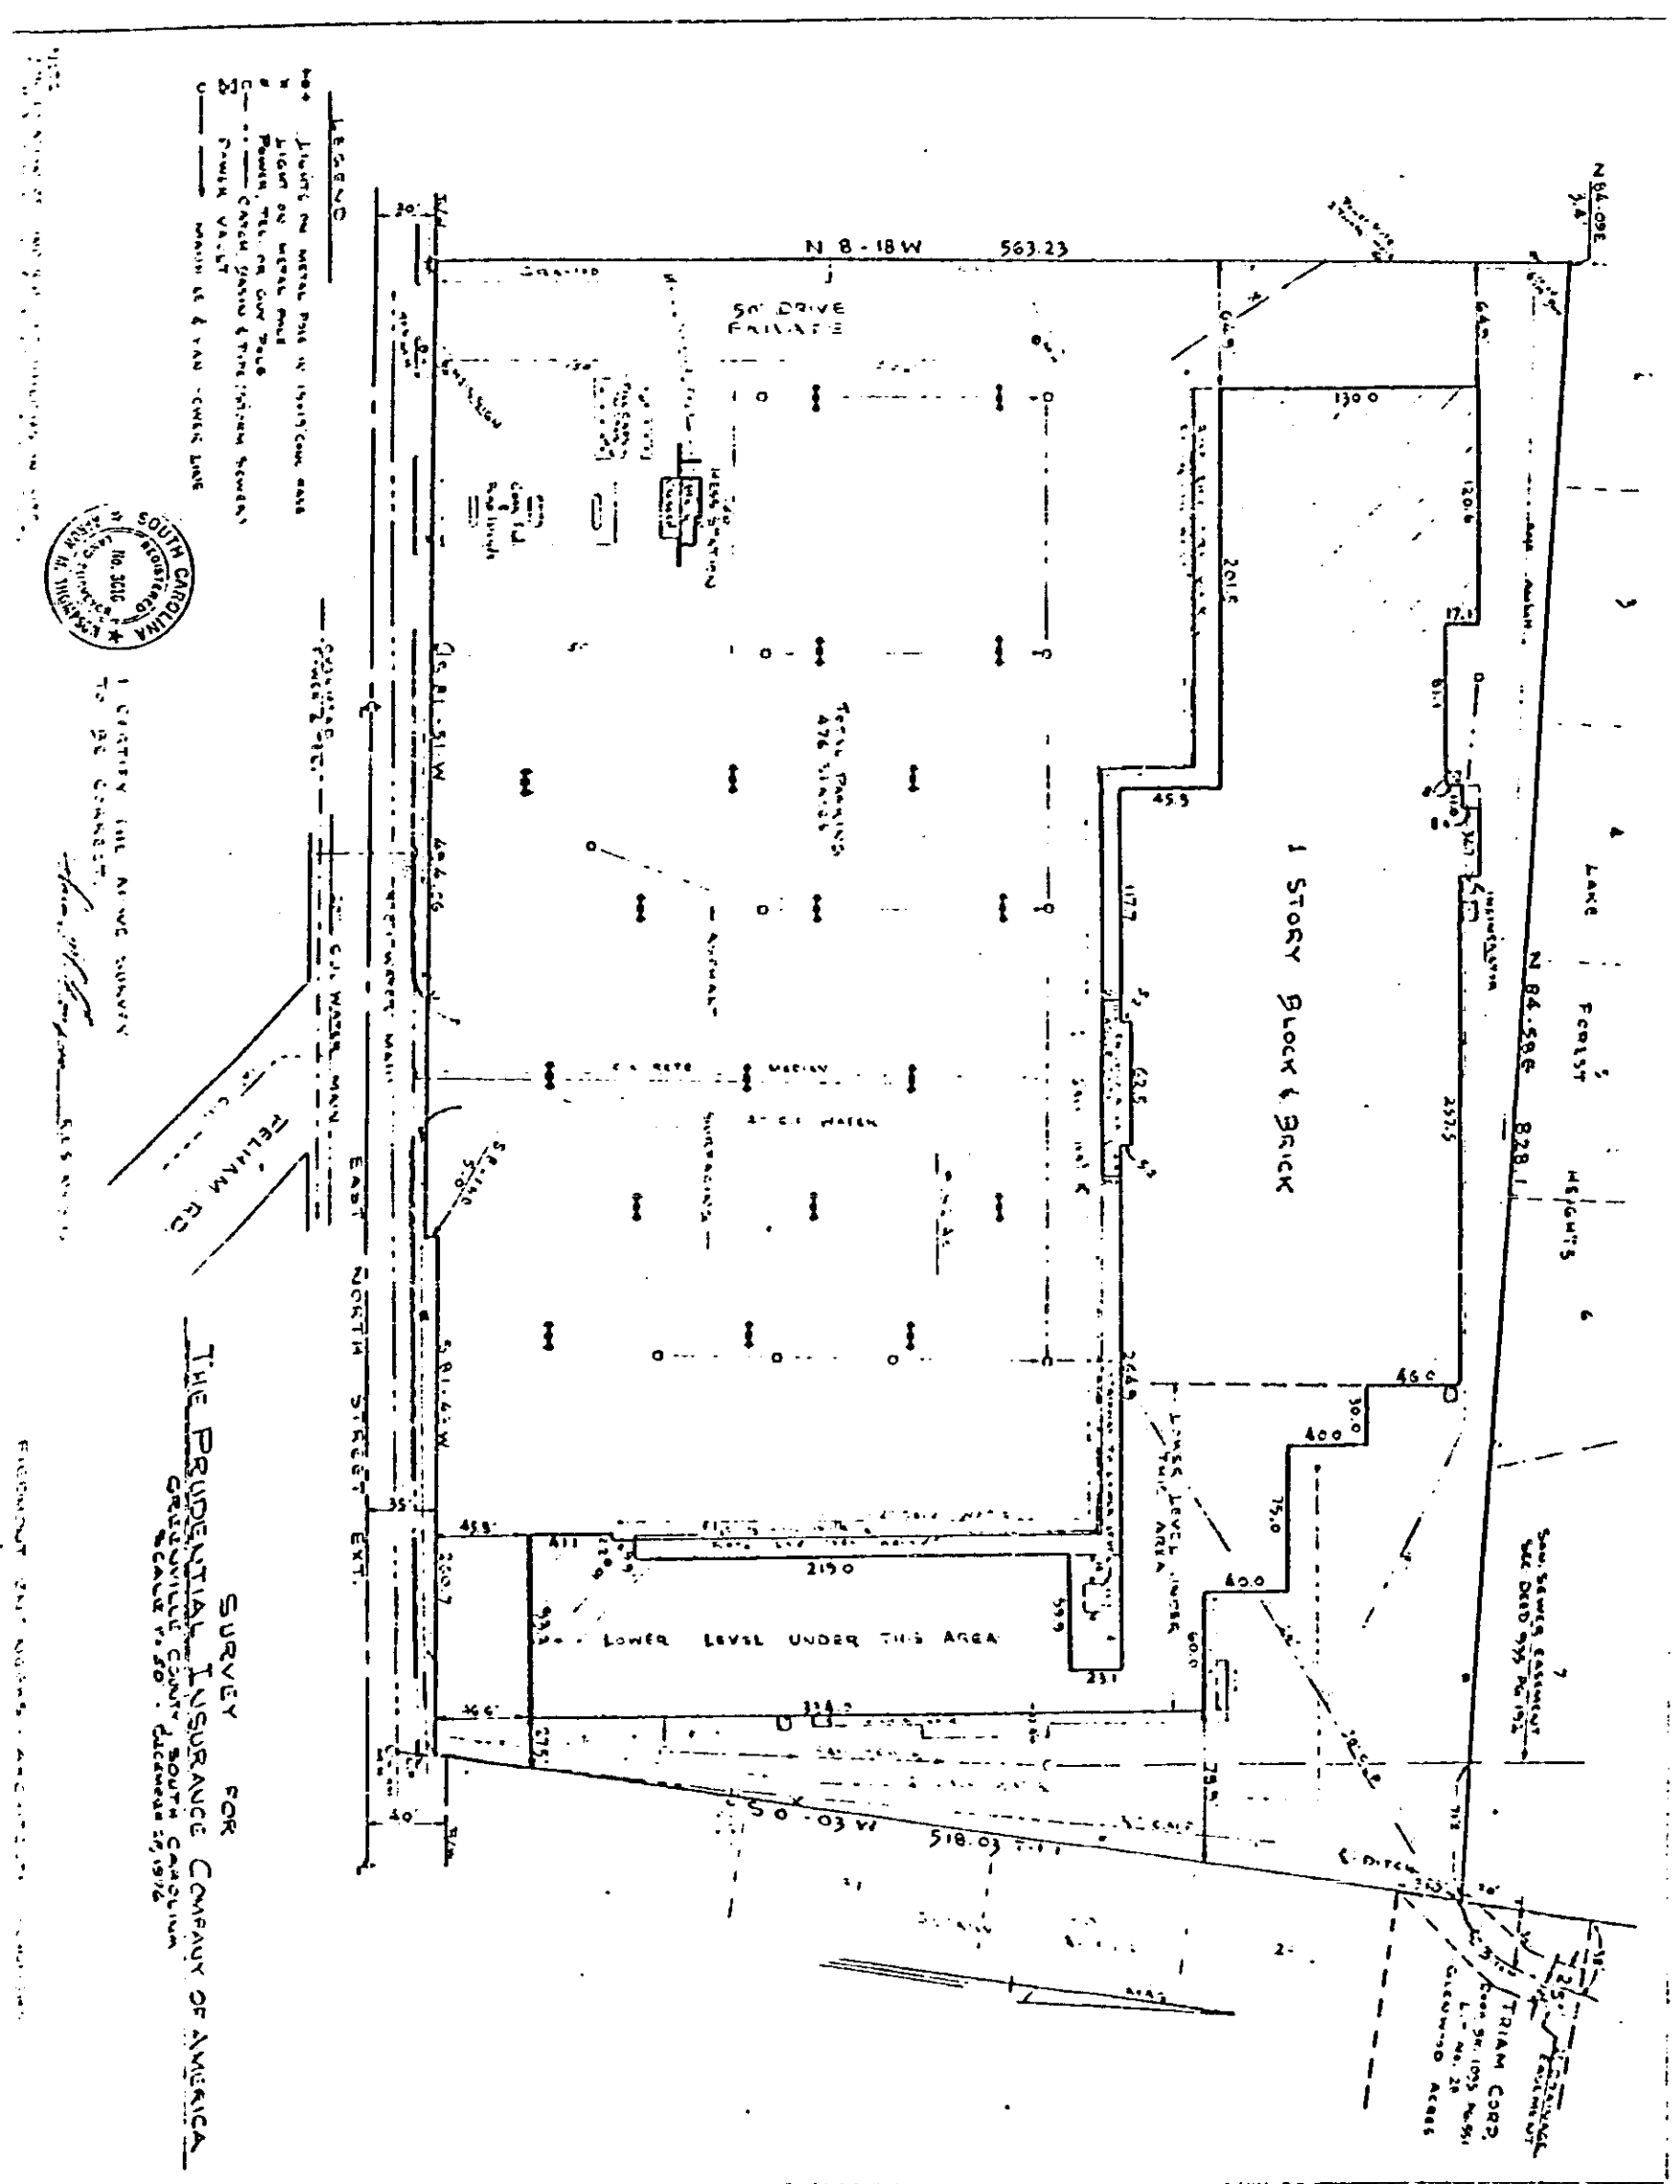

Plat attached to Consent Agreement filed pursuant to provisions of Article 45 of Title 56, Chapter 5 of the South Carolina Code.

RECORDED NOV 5 1981 at 1:08 P.M.

11259

4328 RV-2