


NOTE: 2" VALVES OPEN LEFT

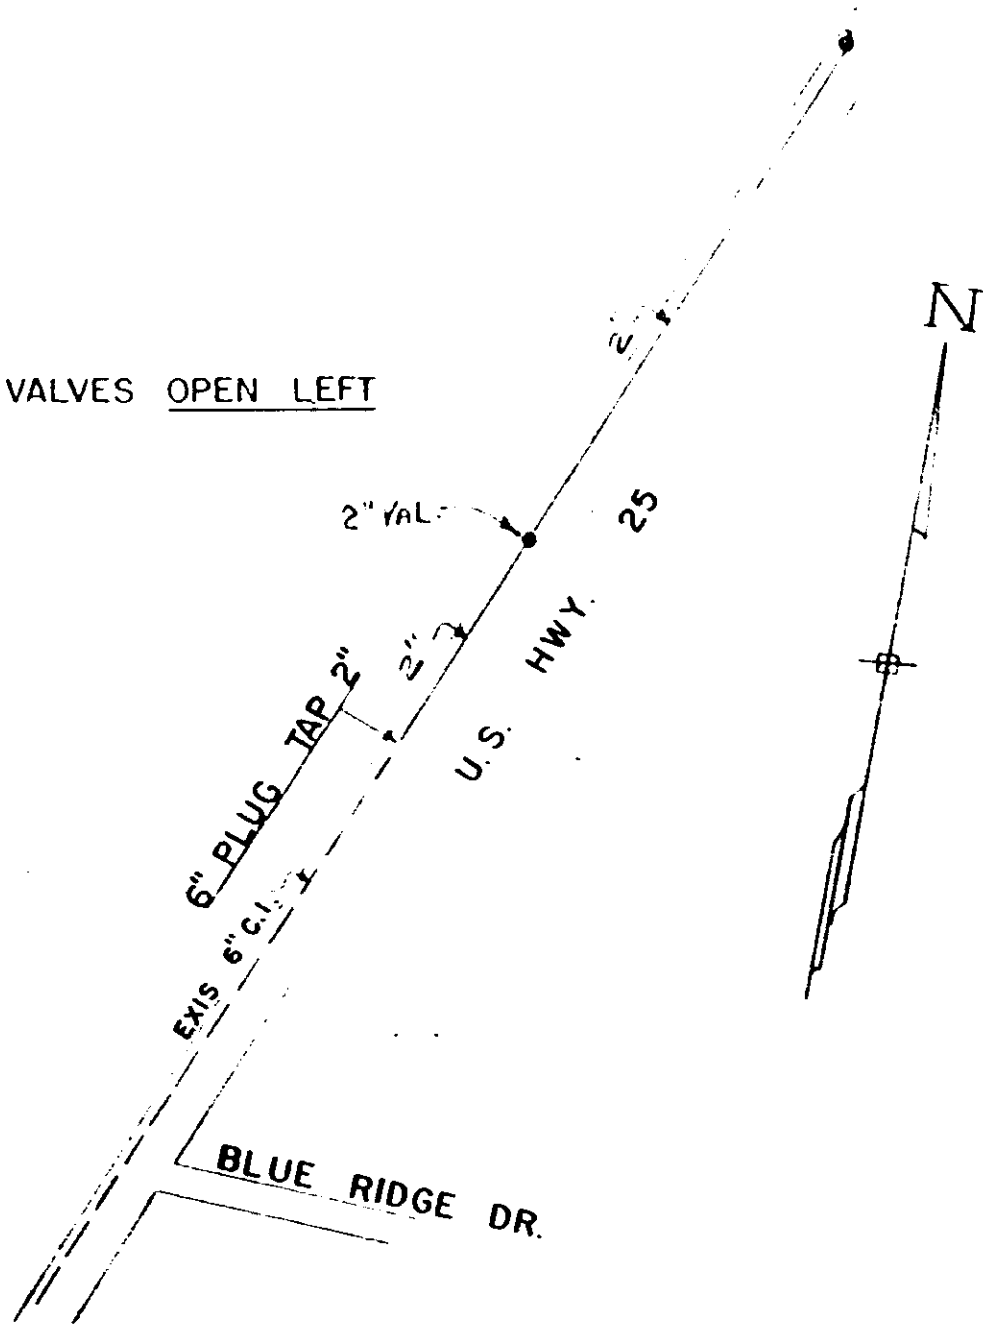

MATERIAL LIST:

2" Galv. Pipe	-	1,600'±
2" Valves	-	2

U. S. HWY. 25

DEC., 1981 SCALE 1"=400'

Joe R. Coleman
 to
 Commissioners of Public Works
 of the City of Greenville, S. C.
 December 21, 1981

RECORDED MAY 19 1982 at 4:53 P.M.

25751

1510

4328 RV-2