

STATE OF SOUTH CAROLINA
 SOUTH CAROLINA TAX COMMISSION
 DOCUMENTARY STAMP TAX
 \$ 01.00

GREENVILLE COUNTY
 102634
 SOUTH CAROLINA COUNTY DOCUMENTARY TAX
 \$ 00.55
 APR-7-83
 PS 12511

Name and Post Office Address of Grantor: Miles Dean Bryant
Mush Creek Road
Travelers Rest, South Carolina

File No. _____


Total Line or Exchange Line tributary to: Travelers Rest Exchange - Travelers Rest Office

The Property is bounded where the line enters and leaves this property by the property of:
Mush Creek Road on the East
 and Mintner on the North

Authority HF3-0153G Classification R45C
 Area South Carolina

Approved: _____
 Title: _____

Vol 1186 Page 134

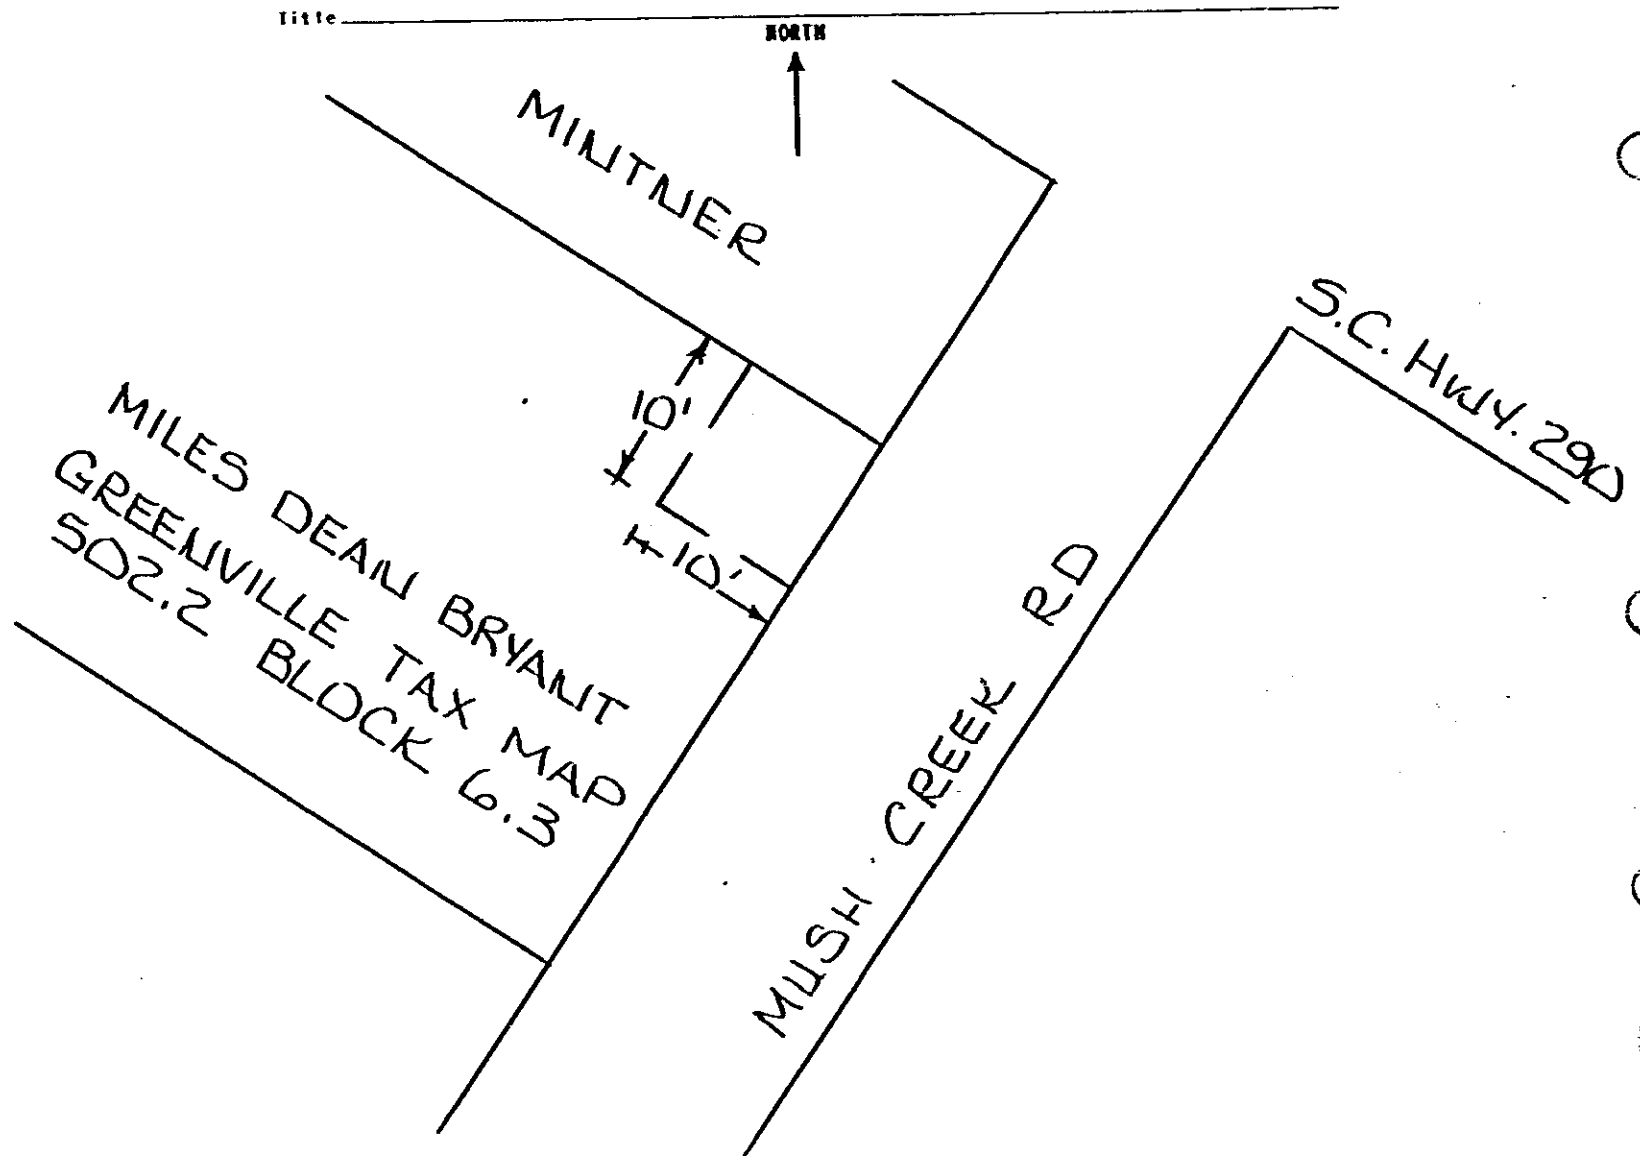

RECORDED APR 8 1983

at 1:33 P.M.

26075

Filed for record in the office of
 the R. M. C. for Greenville
 County, S. C. at 1:33 o'clock
 P.M. Apr. 8, 1983
 and recorded in Deed Book
 1186 at page 133
 R. M. C. for G. Co. S. C.

26075
 X X

APR 8 1983
 mail - see...

